Emma V. Hall Survey Bloomfield Township
R 8 - T 7 Sec. 28

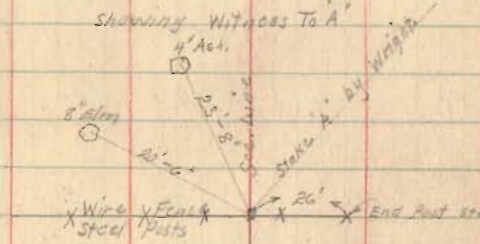

(83)

INDEXED ON MAP

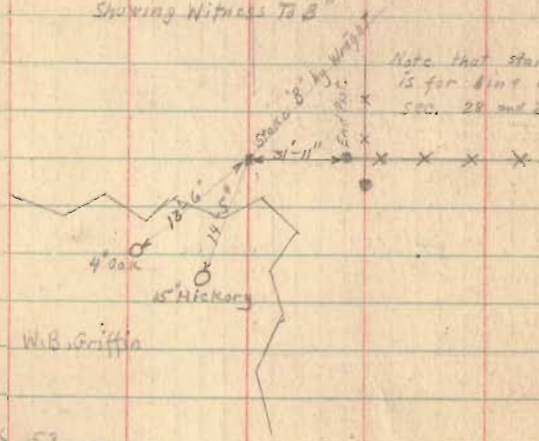

See Book 53 and Box H "H2 for 1906 survey.
Box H1 for 1924
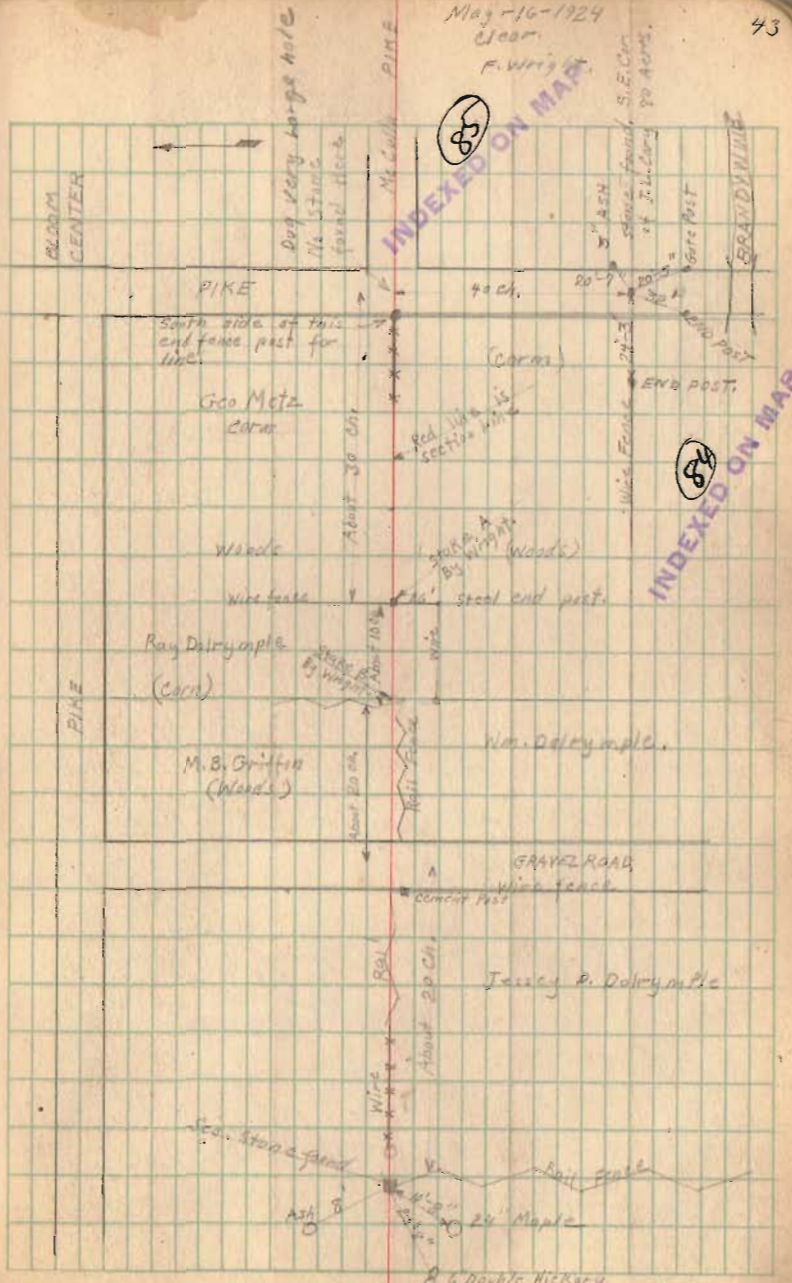
May 1-16-1924
Clear.
F. Wright.