

Shelby Co.

July 10th 54. Course Treaty line from stone at Δ or east $N 80 \frac{1}{2} E$
 to stone at Σ Hogan land in Δ line center N line sec 36
 to Δ 10.55 ch. N post 1 pole south bank Run to Δ or N line at Δ links
 north of Δ 24 di, to Δ 16.10 ch to stone cent. Round pit
 to Δ or N $N 1 \frac{1}{2} W$ 32.78 ch. N to Δ $N 89 \frac{1}{2} E$ 40.25 ch
 Δ to Δ $N 87 \frac{1}{2} E$ 36.78
 Δ from Σ to Δ 25.08 ch.

July 16th 54 try course Treaty line find it $N 80 \frac{1}{2} E$

Set Monument to mark eastern angle of county
 line on Greenville Treaty line at corner Δ then
 to corner stone original corner to Harmon Cole and
 Mr. Hogan. Set monument from Δ $N 1 \frac{1}{2} W$ 25 feet
 From Δ to Δ = or east angle on county line on Treaty line
 = $S 80 \frac{1}{2} W$ 12.04 chains


Set monument to mark ang at Δ = or east ang Δ line
 From Treaty line $S 22 \frac{1}{2} E$ 26 feet N side $\{ \begin{matrix} S 29 \frac{1}{2} E \\ R 7 \end{matrix} \}$ side $\{ \begin{matrix} S 29 \frac{1}{2} E \\ R 5 \end{matrix} \}$

Set Monument to mark ang Δ = east ang Δ line
 From Treaty line $N 1 \frac{1}{2} W$ 25 feet from

N side = $S 36 \frac{1}{2} E$ R 7 Δ side $S 29 \frac{1}{2} E$ R 8
 1684 E. Long, Phil

Sec 36 T7 R7

and pt Sec 29 T2 R8.

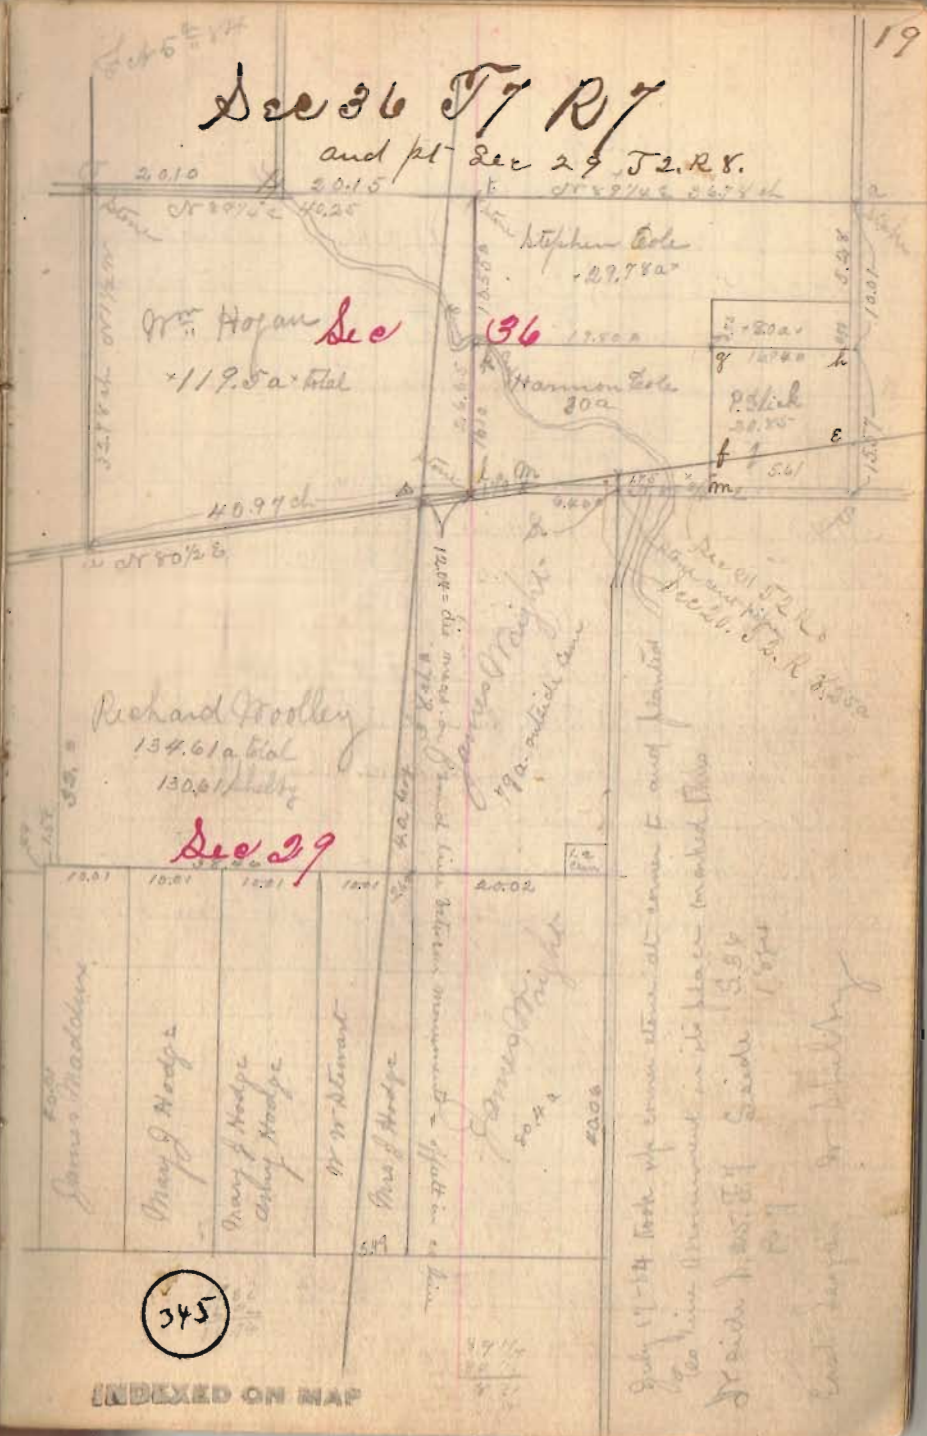

Shelby Co.

Let or mine 10 more west than S of treaty line

Feb 5 22, 6 = stone on line H Cole

L M on treaty line N 50 1/2 E 1.79 ch. M = or road sec 20

K = or sec 21 ^{line B} start at K then with north

line sec 28 and S line sec 21 N 87 1/2 E

at chains on road south

" 3 ch cut Run

" 6 " H Cole stone left 8 poles

" 11.40 ch point on line H Cole + P Glick

" 16 ch Glick house, at 28.31 ch point B

line & start at B N 1 1/2 W

at 15.57 ch find N 2 E P Glick + sec 21 H Cole

find stumps of old Vit trees Glick & set stakes 11 links from hick + 28 lbs from bush, line passes 3/4 links west of stake out for 4 + 6.

at 25.54 chains N 2 E sec 36. = to 6 link in east and post shown on east and on part line Stephen Cole land

Line B.

Stephen Cole



345
INDEXED ON MAP