FB 702

C. H. No. 253

Stokes Township

Proposed 80' Dia. Turnaround

3460

INDEXED ON MAP

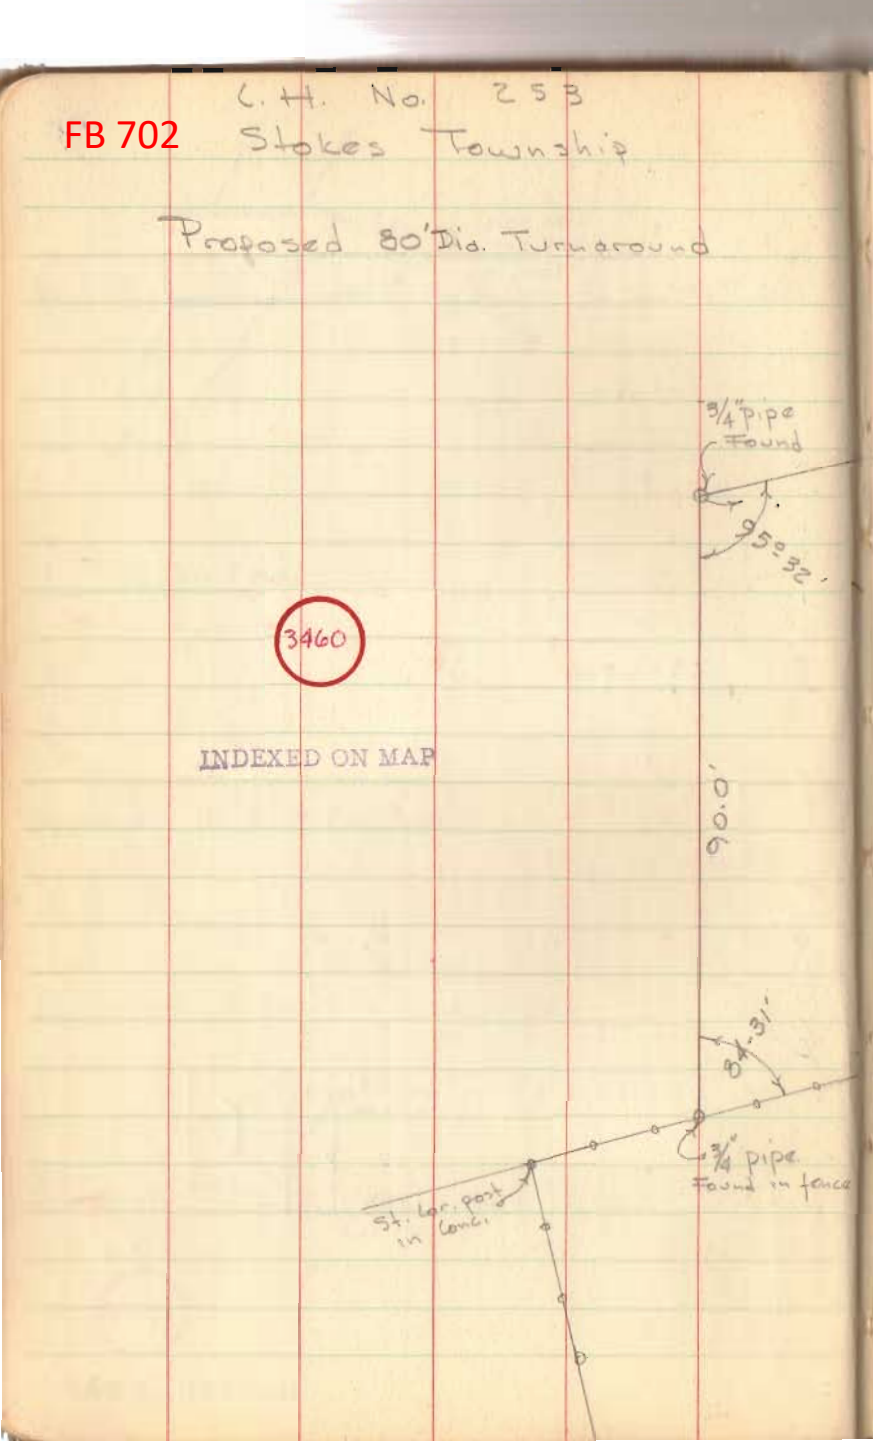

Dodson Twin Line

10/6/60

75°
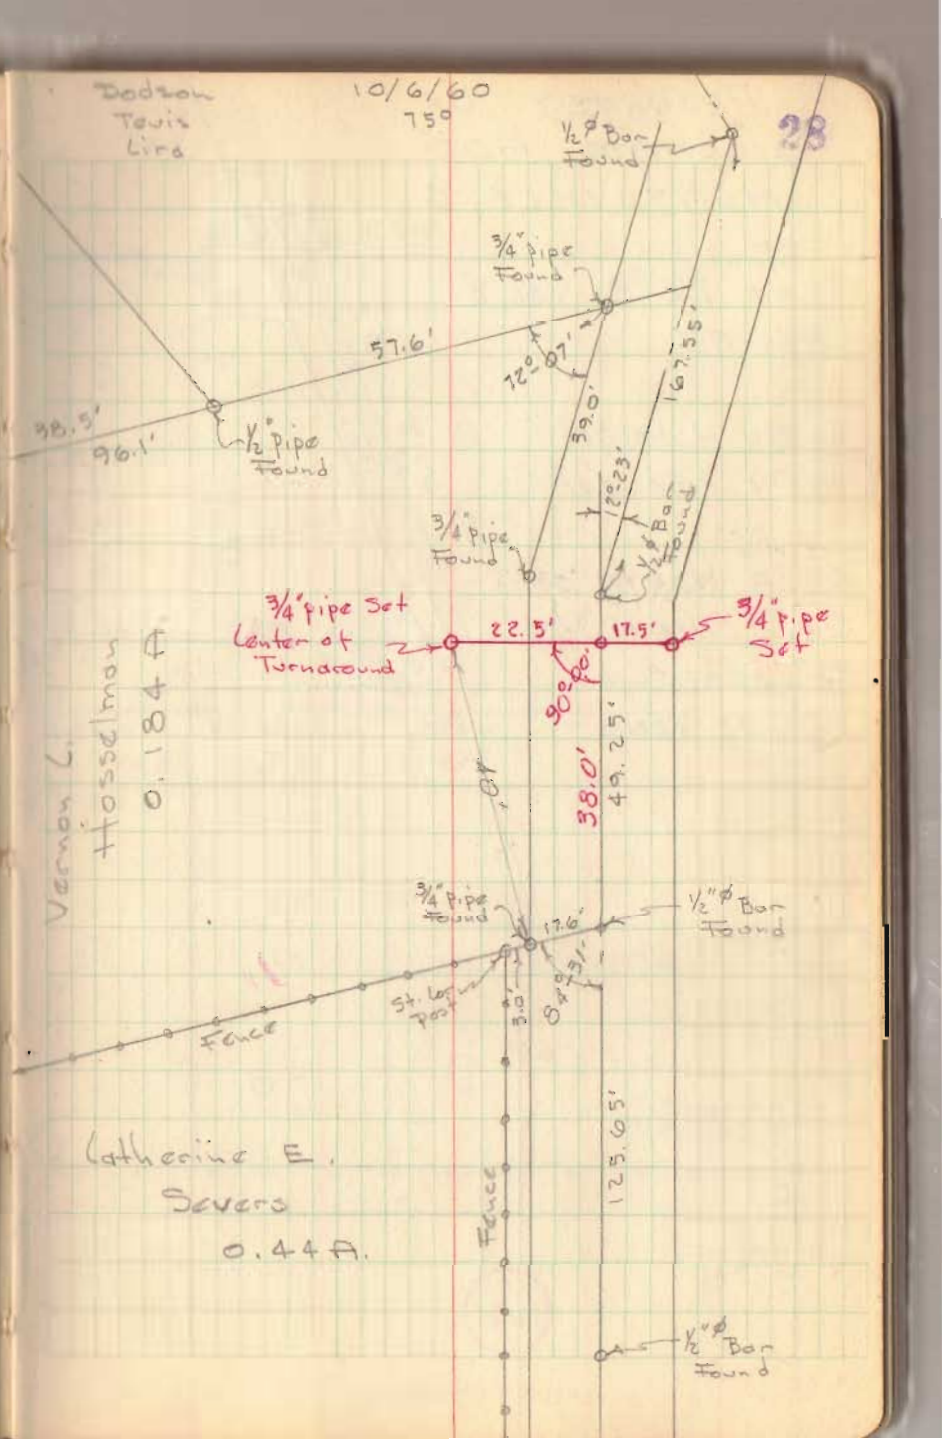
28