Survey Parks–Klay Oil Co.
Sec 5 T. 2 R. 14 Harrison Tp
Crane

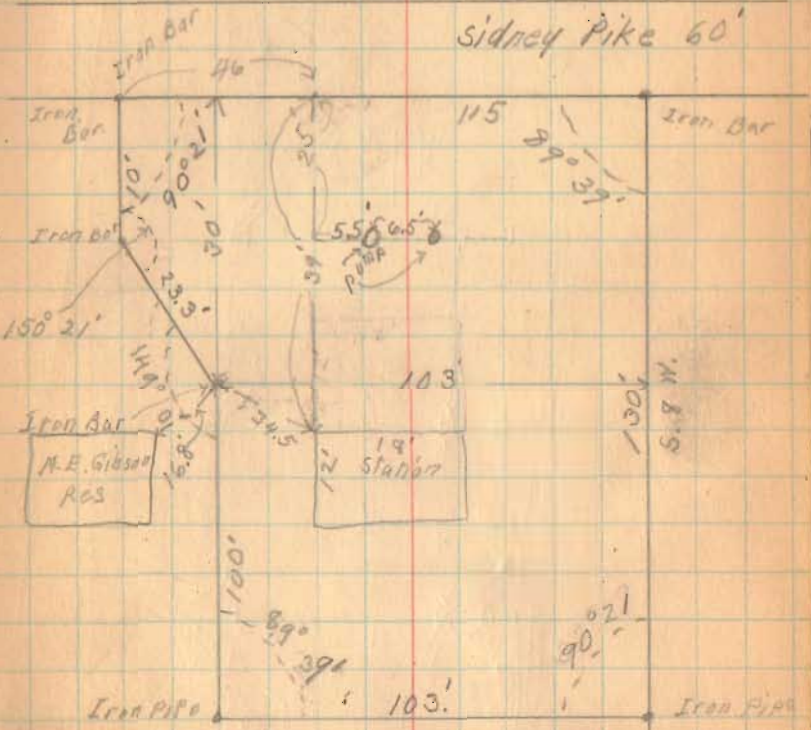

1185
INDEXED ON MAP.

See Drawer R