


4th Mo. (April) 19th 1830 - (Surveyor No. 131)

8244

Surveyed 96 acres of land for James Crew and Martin Marmion, administrators of William Zam dec'd in obedience to an order of the court of common pleas of Logan County Beginning at 2 sugar trees and buck, south west corner to Marmion's 5 acres which he purchased of said William Zam; thence $s 75^{\circ} \frac{3}{4} E$, crossing a road at $3^{\frac{1}{2}}$, and a spring branch at 35 poles, 76.7 poles to a stone touch, sugar tree and iron wood, and corner to said Marmion's lot of land; thence $s 75^{\circ} \frac{3}{4} W$ crossing a small branch at 27 , and a road at 57 poles, Mad River at 123 poles, 187 poles to the centre of the Spring branch, which formerly ran by the sawmill; thence down the branch with its meanders to where the line between the heirs of Robert Armstrong and

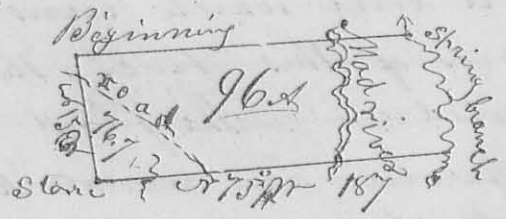

William Zam crosses said branch; thence $s 75^{\circ} 45' E$, crossing Mad River at 115 poles to the beginning containing 96 acres, $s 75^{\circ} 45'$ part of survey no 3107 in the name of the Rep. of James Calderwood

Robt. M. Marmion }
Benj. Butler }
Ja. Crew }
witness

Ja. Marmion }
witness

8245

7th Mo. (July) 31st 1830 - (Surveyor No. 132)

Surveyed 10 1/4 acres for Robert Patterson; Beginning at a stake in the centre of the road or street, in the south line on the south side of Bellefontaine; thence with said line, west 68 poles to a stake in the east line of John Powell's land; thence south 95.9 poles to a stake, the centre corner of section 34 Town 4 Range 14 N.W. thence east 68 poles to a stake in the road from Bellefontaine to Urbana; thence with said road north 95.9 poles to the beginning; Robert & Melrose Christy Herutz }
witness }
Ja. Marmion }
witness

