14

Survey for J. F Wish
V. M. S. 3317
Lake Twp. Logan Co O

509.5
486.4
2/995.9
498
787
3486
3984
3486
391926
2460
41653

Road 30x82
30
2460

4356 / 41653 (.96
39204
2449Q

Surveyed 0.96 Acres
as shown for J. H. Wish

C. A. Inskeep
J. C. Crone
J. H. Inskeep
G. C. Inskeep

Aug 16, 1933

14

See Page 17

This book

60'

Survey 3329
Survey 3317

Donell Road.

J. F. Wish

State R. of W. 200'
Mon Sta 82+00
(Found)

Iron pipe (Set)

509.5'

Iron pipe (Set)

Iron pipe (Set)

Iron bar (Found)

Pipe

Iron pipe (Set)

Survey 3317

Survey 3329

Iron pipe (Set)

Survey 3317

Survey 3329

Iron pipe (Set)

Iron pipe (Set)

Iron pipe (Set)

See page 14 this book

Survey for J. F. Wish
W. M. S 3317
Lake Twp. Logan Co O

Surveyed 1.00 acre and
2.00 acre tracts as shown.

5/7/43
J. H. Hoskeep
Don Dysert

Found iron pipes at A and
B. Did not find iron bar
at C. Set 1½" pipe at C
Found iron bar at D.

C A Hoskeep
J H Hoskeep.

Oct. 20, 1934

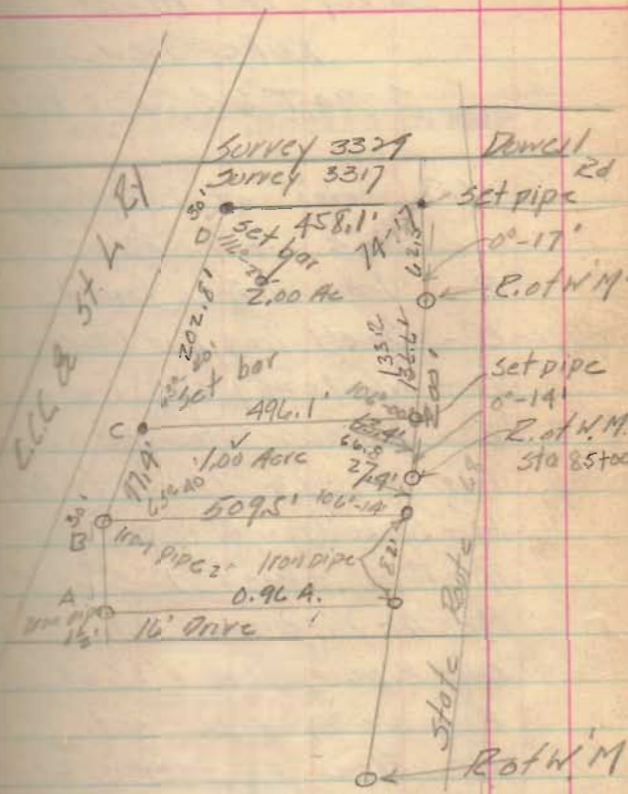

INDEXED ON MAP

2261