


Dec. ✓ 1835

N^o 301 Surveyed Dec. 16. 1835 for Michael Muffelman the following tract of land to wit Beginning at a stake from 3 poles from the South Easterly, comes to Lincoln McArthur's Survey N 10 40 E & 10 179. then N 80 E 126 poles, crossing Rush Creek at 84 & small branch at 110 poles, to an Elm Ash & Gum, then N 12 W 138 poles, crossing Rush Creek at 118 poles, to an Elm & 2 oaks on black & gray, then S 26 W 196 poles, crossing a bend of Rush Creek at 104 poles, to the beginning containing 27.16 acres.
 M. Muffelman }
 J. Muffelman } ch. can.
 D. Hopkins S. G.

13523

8359

N^o 302 A part of N^o 4493 Surveyed Dec. 21. 1835 for Isaac Startuck Beginning at a Crab Apple bush in the edge of a prairie, then S 70 W 134 poles, crossing a big road & small branch several times, to a stake on the top of a ridge near a hickory & small Jack Oak stub, then N 38 E 93 poles, to small W. & 66. Oak. then N 67 E 121 poles, crossing the big road a small river stream to a stake in a bunch of willows on the bank of the river, then N 20 W 89 poles, crossing the river twice to the beginning. Containing 78 acres 60 hundredths.
 I. Startuck }
 Derby, Sonny } ch. new
 D. Hopkins S. G.

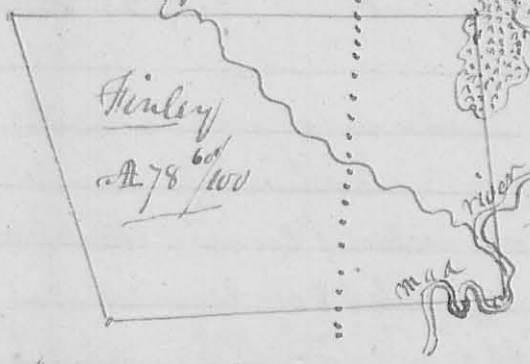

 George Kniskern }
 Hickory } ch. new
 D. Hopkins S. G.

