


Hoon-Beck Alley  
 Lakewood, Ohio  
 Established 14' by Village council  
 See FB 493 pg 20-2  
 - FB 418 pg 42

E. K. Core

60

Lot # 25

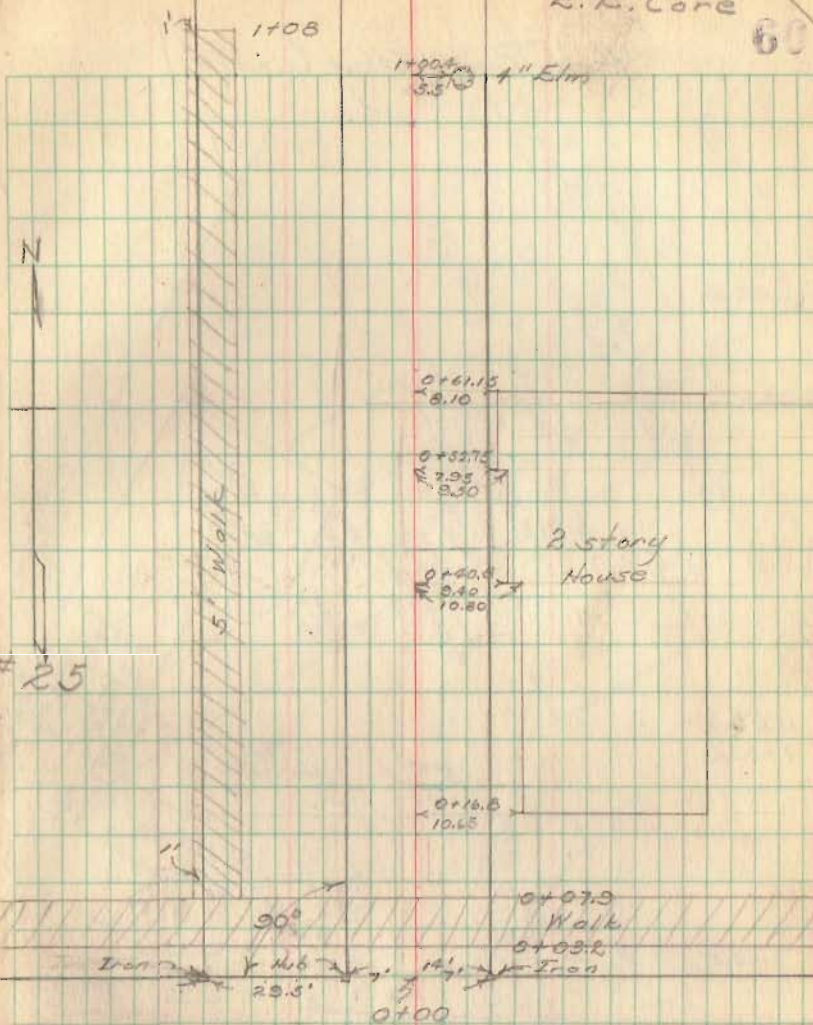

INDEXED ON MAP

2458

