

ENGINEER'S OFFICE

The accompanying Plat approved on this the 25 day of January 1958.

715 Miller
Logan County
Engineer

SURVEYOR'S CERTIFICATE

The accompanying Plat represents a subdivision of land in the Village of Lakeview, Stokes Township, Logan County, Ohio and being part of the Northwest 1/4 of Section 34, T-6S, R-8E of the First Principal Meridian. The tract has an area of 1.57 acres in streets and 4.16 acres in lots making a total of 5.53 acres. The Streets are 50.0 feet wide. All measurements are in feet and tenths of feet. I = 3/16" iron pins. I hereby certify that the accompanying Plat is a correct representation of WEST-ACRES, as surveyed October, 1956.

Don R. Dohm
Registered Surveyor
No. 4870



ACCEPTANCE

The annexed plat is hereby adopted by Ordinance Number 396 as an addition to the Village of Lakeview at a regular meeting of the Village Council on this 17 day of December 1956.

Paul L. Davis Mayor
Paul P. Collins Clerk
George Richardson Pres. of Council

DEDICATION

Know all men by these presents that the Western Ohio Development Co., proprietors of the land indicated on the accompanying Plat have authorized the platting thereof and do hereby dedicate the Streets to the public use forever.

WESTERN OHIO
DEVELOPMENT Co.

William D. Mitchell President
William Kuntz Vice Pres. & Secretary
How Bookwalter Witness
Edward Kuntz Vice Pres. & Secretary

AUDITOR'S OFFICE

The within lots transferred this 23 day of January 1958.

Harry L. Davis
Logan County Auditor

RECORDER'S OFFICE

Received for record at 3:30 o'clock P.M. on this 23 day of January 1958. Recorded in Plat Book 4, Vol. D, Page 38.

Rowena L. Sawyer
Logan County Recorder

STATE OF OHIO
COUNTY OF Montgomery SS

Be it remembered that on this the 12 day of November in the year of our Lord One Thousand Nine Hundred and Fifty Six, before me a notary public in and for said County, personally came William Kuntz, President and Edward Kuntz, Vice Pres. and Secretary and grantors in the foregoing dedication and acknowledged the signing thereof to be their free and voluntary act and deed, their free act and deed as such officers, respectively and the free and voluntary act and deed of said company.

Edwin H. Haug
Notary Public
Nov. 26, 1958
My Commission Expires



WEST-ACRES

AN ADDITION TO THE VILLAGE OF


LAKEVIEW

SECTION 34 TOWN 6S. RANGE 8E.

STOKES TOWNSHIP LOGAN COUNTY, OHIO

1956

COUNTY
3267
INDEX NO.
INDEXED ON MAP

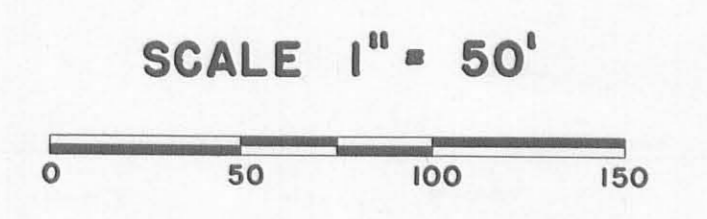


Lot # 612
West Acres - Lakeview

Dodson
Geos. Inc.

9/13/58

75

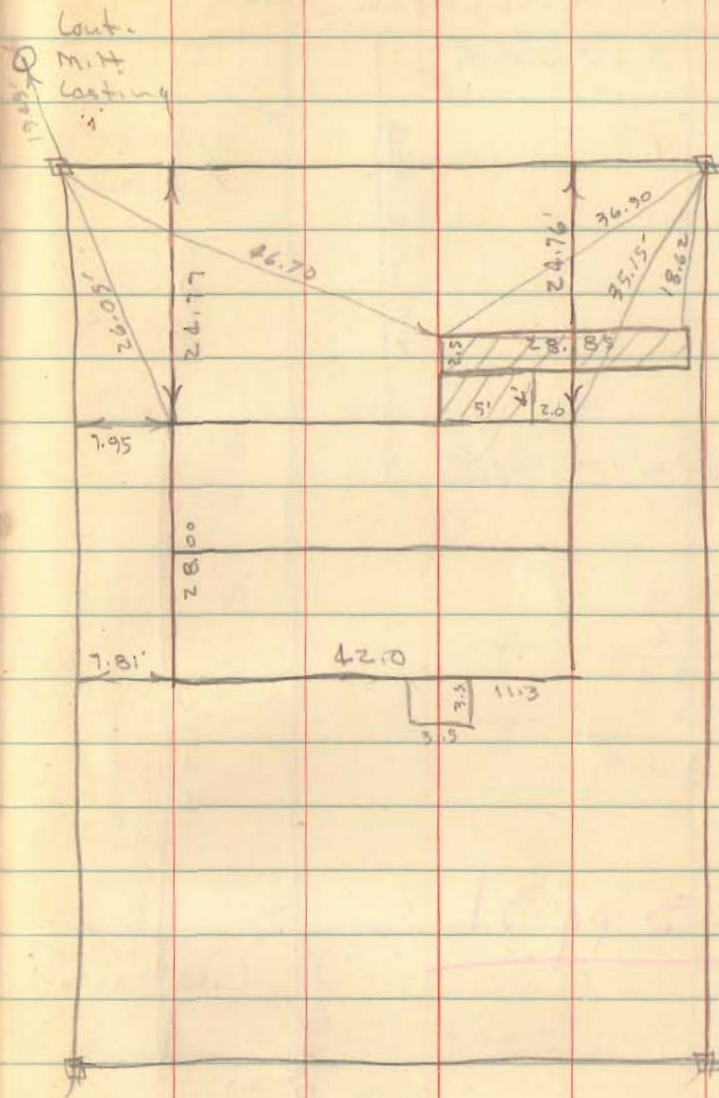

INDEXED ON MAP
3267