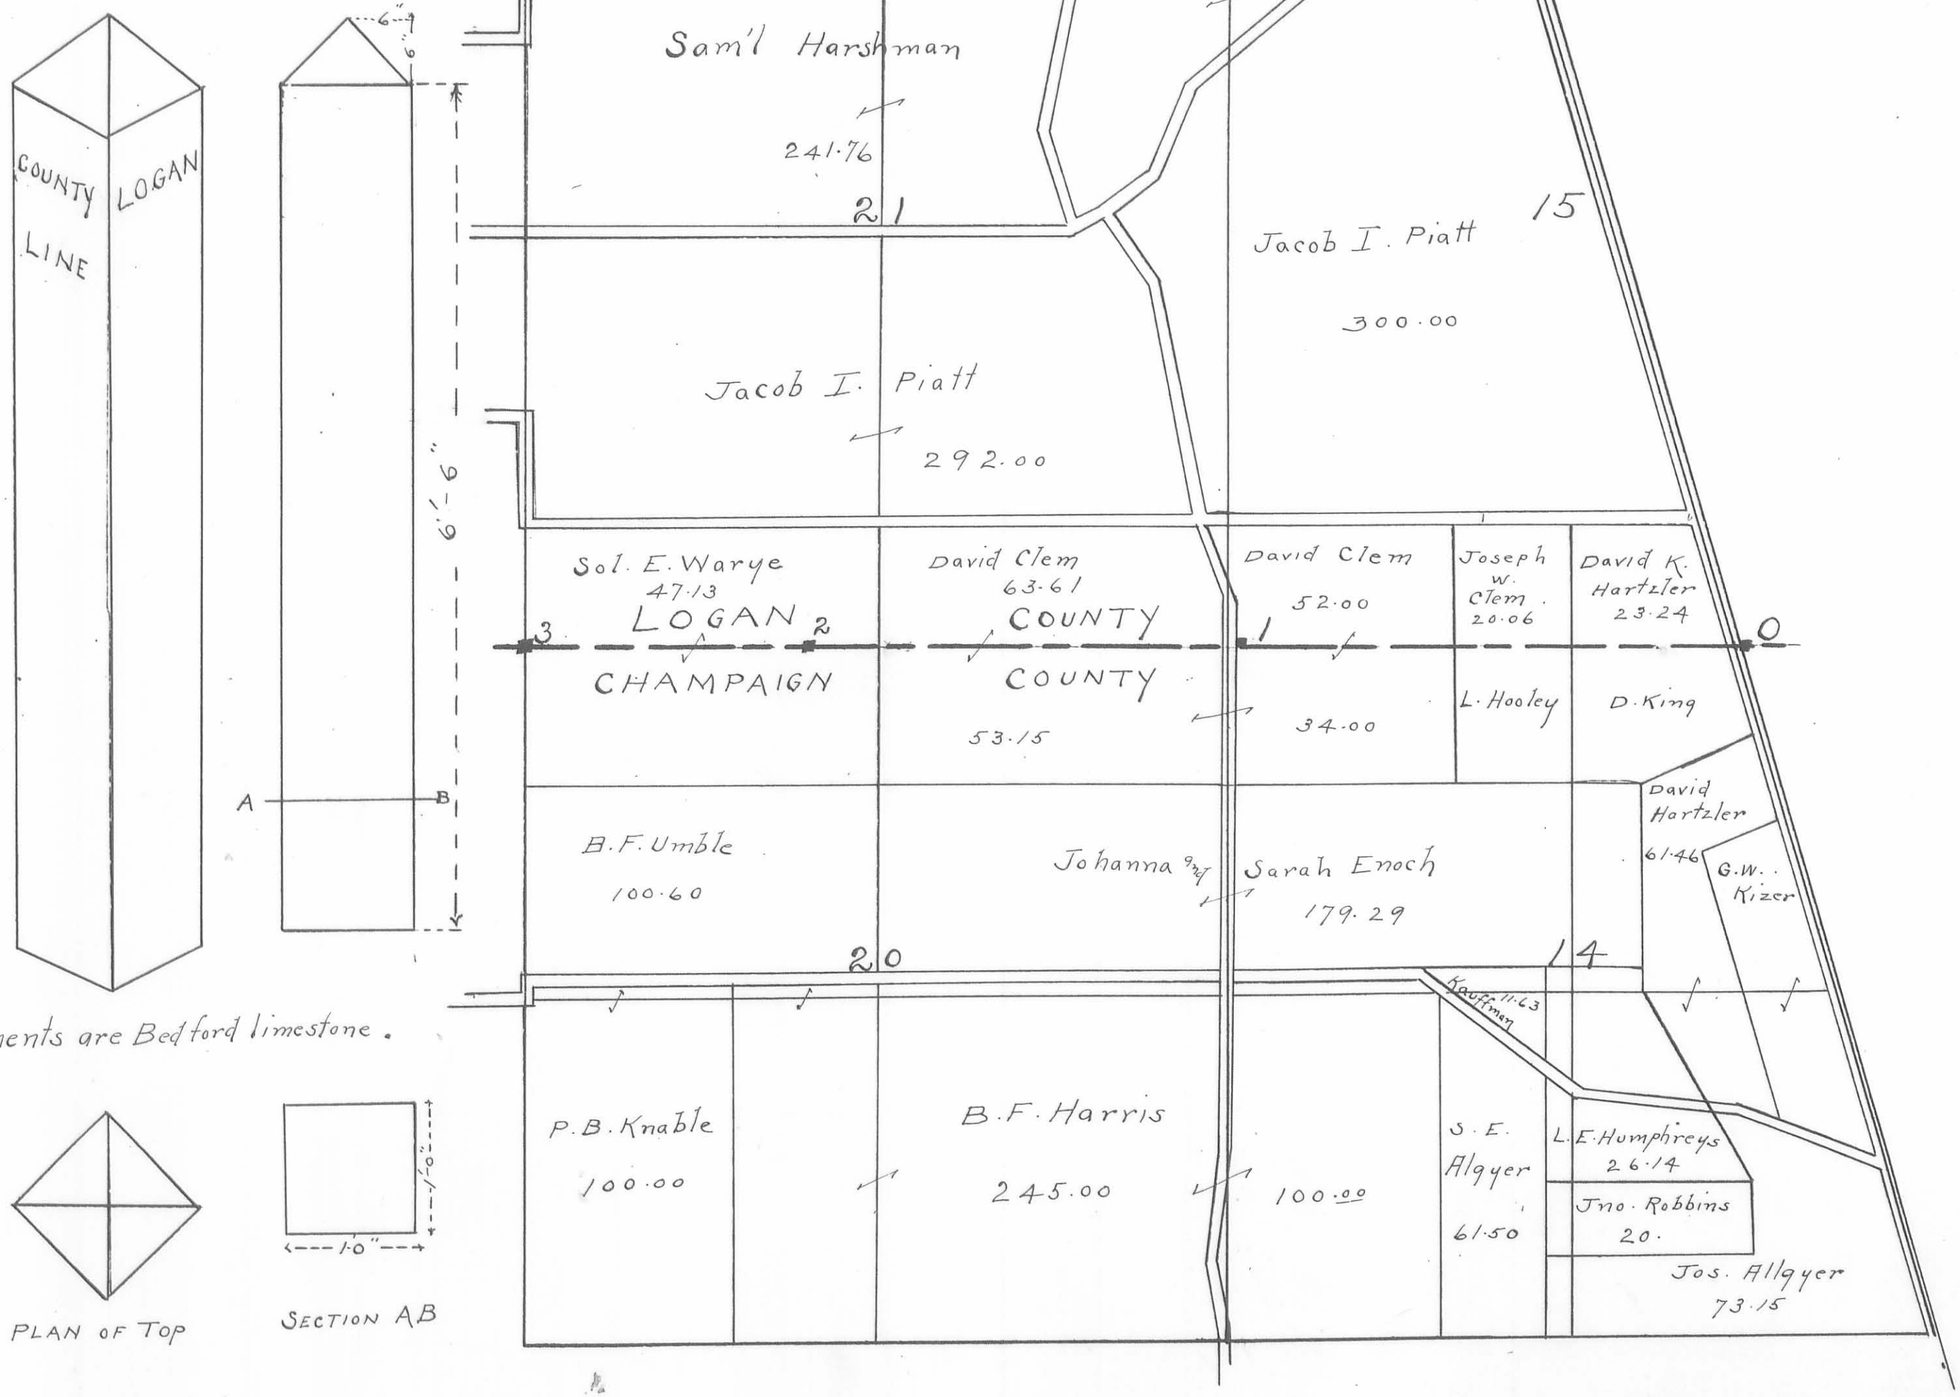

PLAN OF MONUMENTS

No. 0. — Stone — On line at East side Ludlow road.
No. 1 — Stone — 20 feet East and 10 feet north of Section Corner.
No. 2 — Stone — On line 190 feet west of Quarter Corner.
April-19-1917 No. 2 - Stone moved west 6.8 ft - now 196.8 " " " " " .

W. V. Scott,
Co. Surveyor.