24

Job No 138
for
Joe Garber

530 T 8 R 13 WC
Liberty Twp
Logan Co

See Book 10 Page 103 7/18/47

A set Iron Pipe
B " " "
C " " "
D " " "
E " " "
F " " "

12-26-47
J. H. Inskeep
Bob Hughes

25

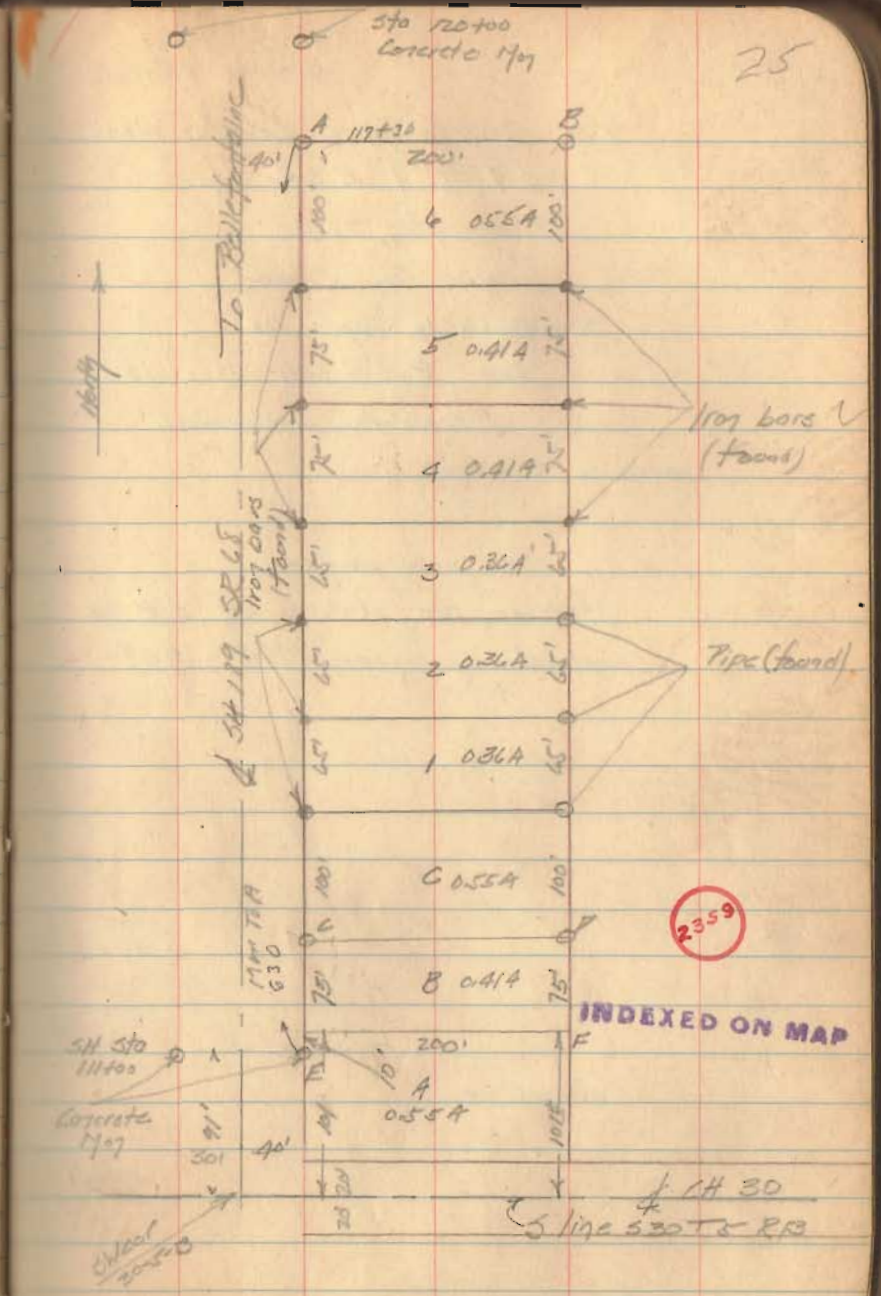

2359
INDEXED ON MAP