

ARNOLD DESCRIPTION  
(August, 1967)

Being situated in Section 1, Town 3, Range 14, in Liberty Township, Logan County, Ohio-

Beginning at a point in the west line of Liberty Township that bears S 6°-05'W 525.5 feet from the intersection of said west line of Liberty Township and the center line of County Road #186. Said beginning point is also at an angle of County Road #32. (See County Engineer's Field Book 559, page 61).

Thence with the said west line of Liberty Township S 6°-05'W 603.5 feet to a corner post.

Thence S84°-43'E 579.0 feet to a concrete corner post.

Thence N 6°-05'E 592.5 feet to an iron in the center of County Road #32.


Thence with the center of County Road #32 N85°-18'W 98.0 feet to an iron at an angle.

Thence continuing with the center of County Road #32 N83°-18'W 481.0 feet to the place of beginning.

Containing 7.93 acres more or less, and surveyed from a 15.00 acre tract.

---

Owen K. Shirk  
Surveyor 4271

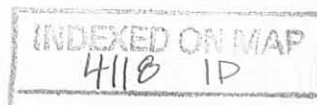

Wm Arnold  
Sec. 1 T-3, R-14  
Liberty Twp

O.k. 5.10

49

Stone at intk of Co. Rd 186

572.5  
Dead

525.5

534.5 to Pad →

89° 22'

107° 22'

Co. Rd 186

21047

90° 33'

N83°-18'W  
481.0

178°-00'

98.0

Co. Rd. #32

91°-23'

See F.B. 559, pg 61

Union Twp

603.5  
LIBERTY TWP

7.93A

588.5

4118 IP

INDEXED ON MAP

Conc. Post

579.0

Cor. Post