Denmead Survey Mar. 13th 1916

Ed Bender Jr. & Co.

Hermann Wagner

R. P. STUDLEY & Co., Manufacturing

STATION.	ALIGNMENT.	DEFLECTION.	REMARKS.
	Survey 100 a for Mollie S. Denmead in Surv. 10951 (9925) (9946) (10121)		
	Course of road & line of Survey N 84 W N 8 W		
	(1) Start 20' N of stone in road S 82 W		
	at 1955 (1255) fall 20' N of stone & mark 5" in top & W &		
	Mollie Denmead & D. E. & Lucy A. Patterson.		
	Correct course & distance (2 & 3) S 82 W 1955' = 29.62 chains		
	(2) Start 25' E of stone S.W. & Denmead N 8 W		
	at 2231 fall 27' E of line fence in Patterson		
	Mollie Denmead & Lucy A. Patterson		
	at 2231 (2230) set stake in line fence = N 82 E 100 a		
	Correct course & distance (2 & 1) N 8 W 2230 feet = 33.78 chains		
	Note. & Elias Surv. 10951 & W line Denmead land. E to & N. 8 W. 19½ chains		
	(3) Start at & 2231 of (2) N 82 E		
	at 636 set & temp.		
	" 640 " N 1¾'.		
	" 1100 " & S 1¾' \ at 1900 set & dist		
	" 1955 " & line Surv (10121) (9946) in fruit wood at N E & 100 a		
	Correct course & distance (3 & f) N 82 E 1955' = 29.62 chains		
	(4) Start at stone S W & Surv = & d		
	N 8 W with & line and		
	at 2230' set & in road S E & 100 a		
	Correct course & distance (2 & 8) N 8 W 2230' = 33.78 chains		
	Note f = N E & Surv 10951. f to j = N 8 W, 14.28 chains		
	The North line of Surv 10951 & Elias (9925) (9946) (10121) is lost and unknown, the distances, 2 to f & f to g taken from record both of original survey (the Recorders Office) which specifies the width of Surv 10951 (North & South) as 78 poles.		
	The 100 acres, d. k. i. j d. sold by Mollie S. Denmead to Wagner and divided as follows. In Wash. Tp. Surv. 10951 = 42 a. & in (9925) (9946) (10121) = 52 a.		
	In McArthur Tp. Surv 10951 = 58 a & in (9925) (9946) (10121) = 39 a		

TOPOGRAPHY.

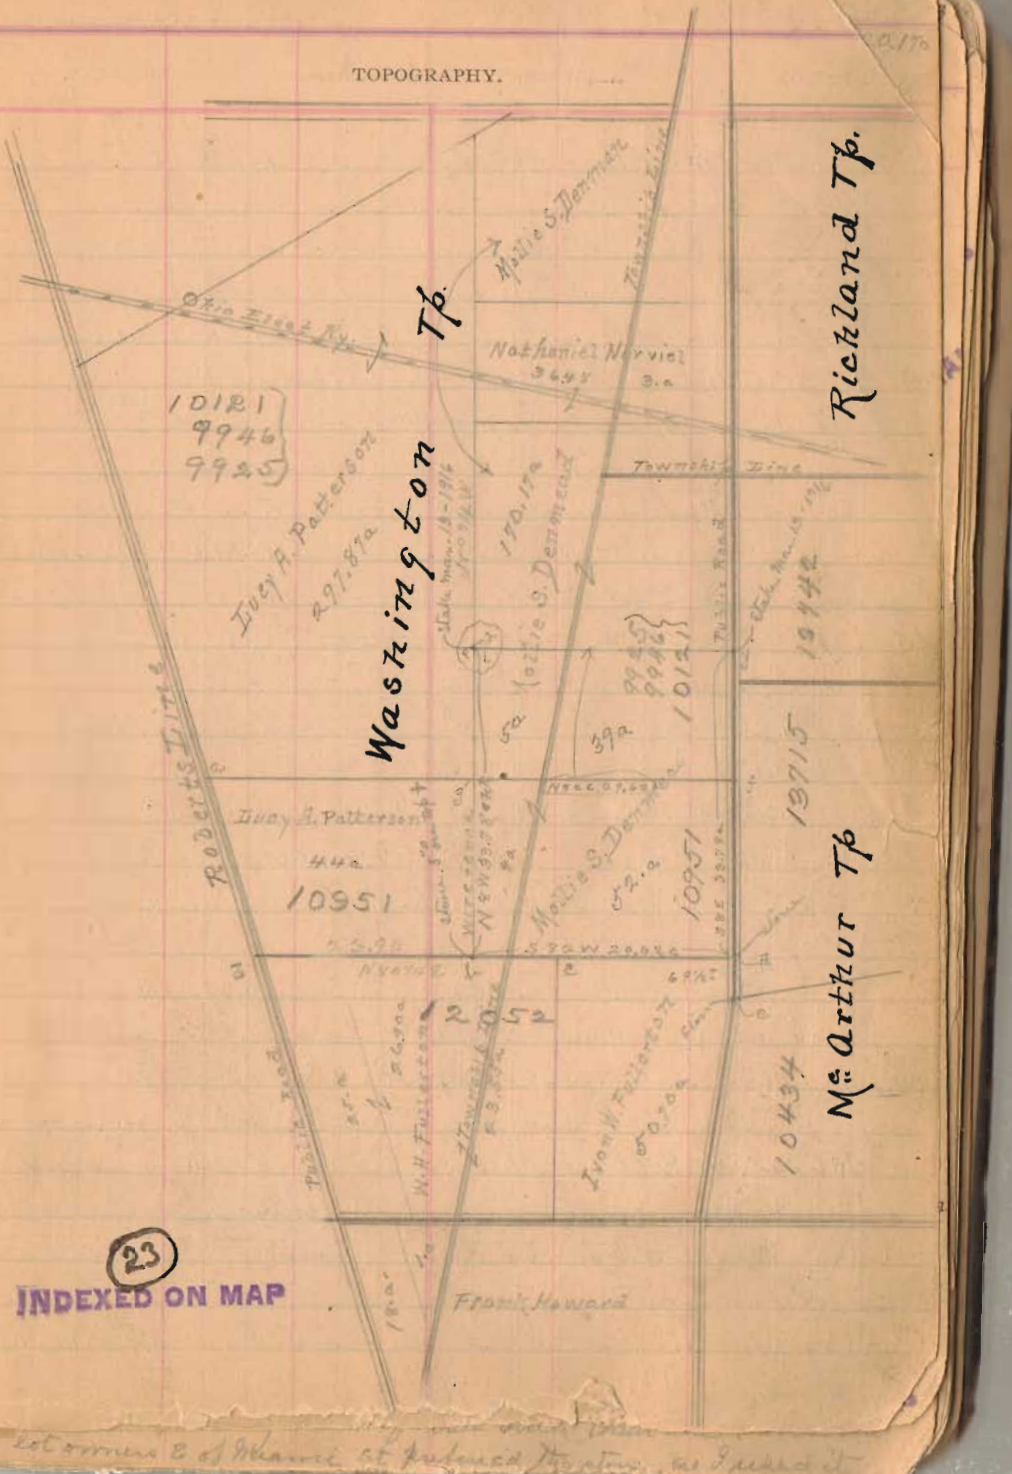

(23)

INDEXED ON MAP

lot corners 2 of Mannie et pulled the stone. as I used it