Alex Forsythe Survey
March 1927
McArthur Twp.

Mil. Surv. 9903-9928

N.E. cor nail driven at NW cor 18.5 from West gate post
19.3 from East gate post

1275 ft from stone on West line

Measured from above nail East 1014.15
Measured from Alex Forsythe East line west
1234.70 ok.

Measured south Alex Forsyth South line 4t
1217.0 ft
29 12.8 ft drove Harrow tooth
interangle 42° 20' (222.31)
200 (35° 21') (238.08)
measured 947.0
Set south 5' 27 10 207 50

Measured 560.8
97 05 297 05
25'
90° 25' bll

92.09

100' 18' 460.9

W A Montgomary
Wm Jenkins

(689)
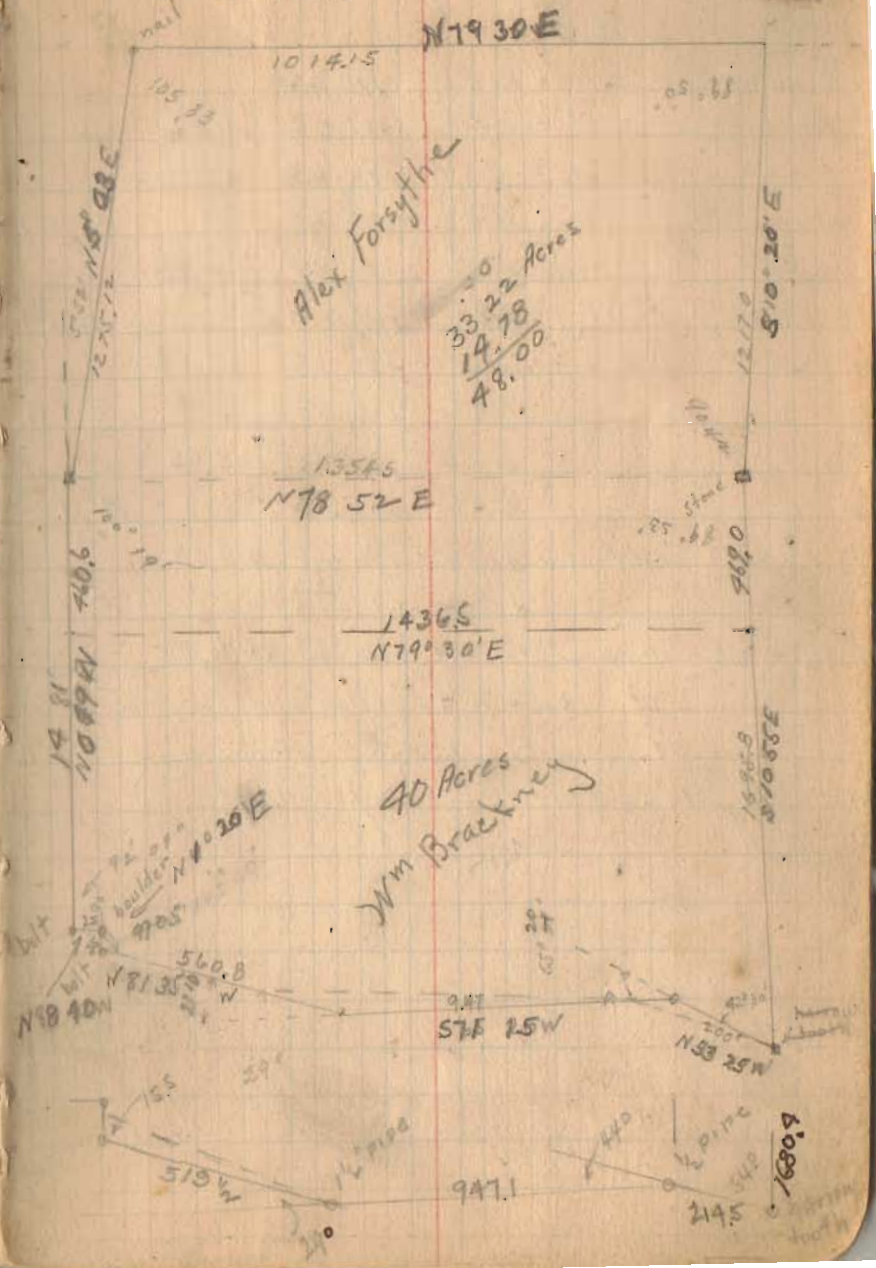
INDEXED ON MAP