


DAVID L. JACOBS
1.39 ACRE TRACT
VOL. 402, PG. 676

MARGARET L. HITES
7.859 ACRE TRACT
O.R. 308, PG. 360

2.000 ACRES
OF WHICH 0.138 ACRE IS
WITHIN THE HIGHWAY RIGHT-OF-WAY

MARGARET L. HITES
7.859 ACRE TRACT
O.R. 308, PG. 360

**RETRACEMENT SURVEY OF THE
JOHNATHAN WILLIAM BRENTLINGER
2.00 ACRE TRACT
OFFICIAL RECORD 380, PAGE 503
VIRGINIA MILITARY SURVEY 9931
McARTHUR TOWNSHIP
LOGAN COUNTY, OHIO**

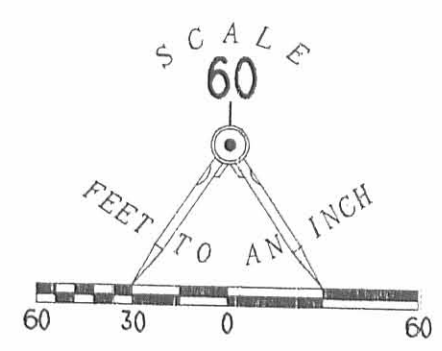

LEGEND

- 5/8 INCH IRON ROD SET
- ⊙ MAG NAIL SET
- ⊗ RAILROAD SPIKE FOUND
- 5/8 INCH IRON ROD FOUND
- 3/4 INCH IRON ROD FOUND IN A MONUMENT BOX



SURVEYED BY:
[Signature]
JEFFREY I. LEE
PROFESSIONAL SURVEYOR 6359
DECEMBER 8, 2000

COPYRIGHT 2000 BY:
LEE SURVEYING & MAPPING CO., INC.
117 North Madriver Street
BELLEFONTAINE, OHIO 43311
(937) 593-7335

INDEXED ON MAP
4684 IP

2 WORKING DAYS
BEFORE YOU DIG
CALL TOLL FREE **800-362-2764**
OHIO UTILITIES PROTECTION SERVICE.

D-392 BRNTLNGR L-3074

J. F. HEMPHILL
62.50 AC

R.R. SPK →

VMS 9930
VMS 9931

N 80° 22' E
290.4'

3/4" IRON BAR



V.M.S. LINE
C.R. 49 (40')
N 11° 00' W. 300.0'

2.00 AC.

S 11° 00' E. 300.0'

R.R. SPK →

290.4'
S 80° 22' W.

3/4" IRON BAR

DOYLE S. BEARD ETUX
127.0 AC.

BEARD SURVEY
7/15/70
V.M.S. 9931
MS ARTHUR TWP.
LOGAN COUNTY, OHIO
SCALE 1" = 50'

INDEXED ON MAP

4684 2P

LESLIE H. GEESLIN
REG. SURVEYOR 5248