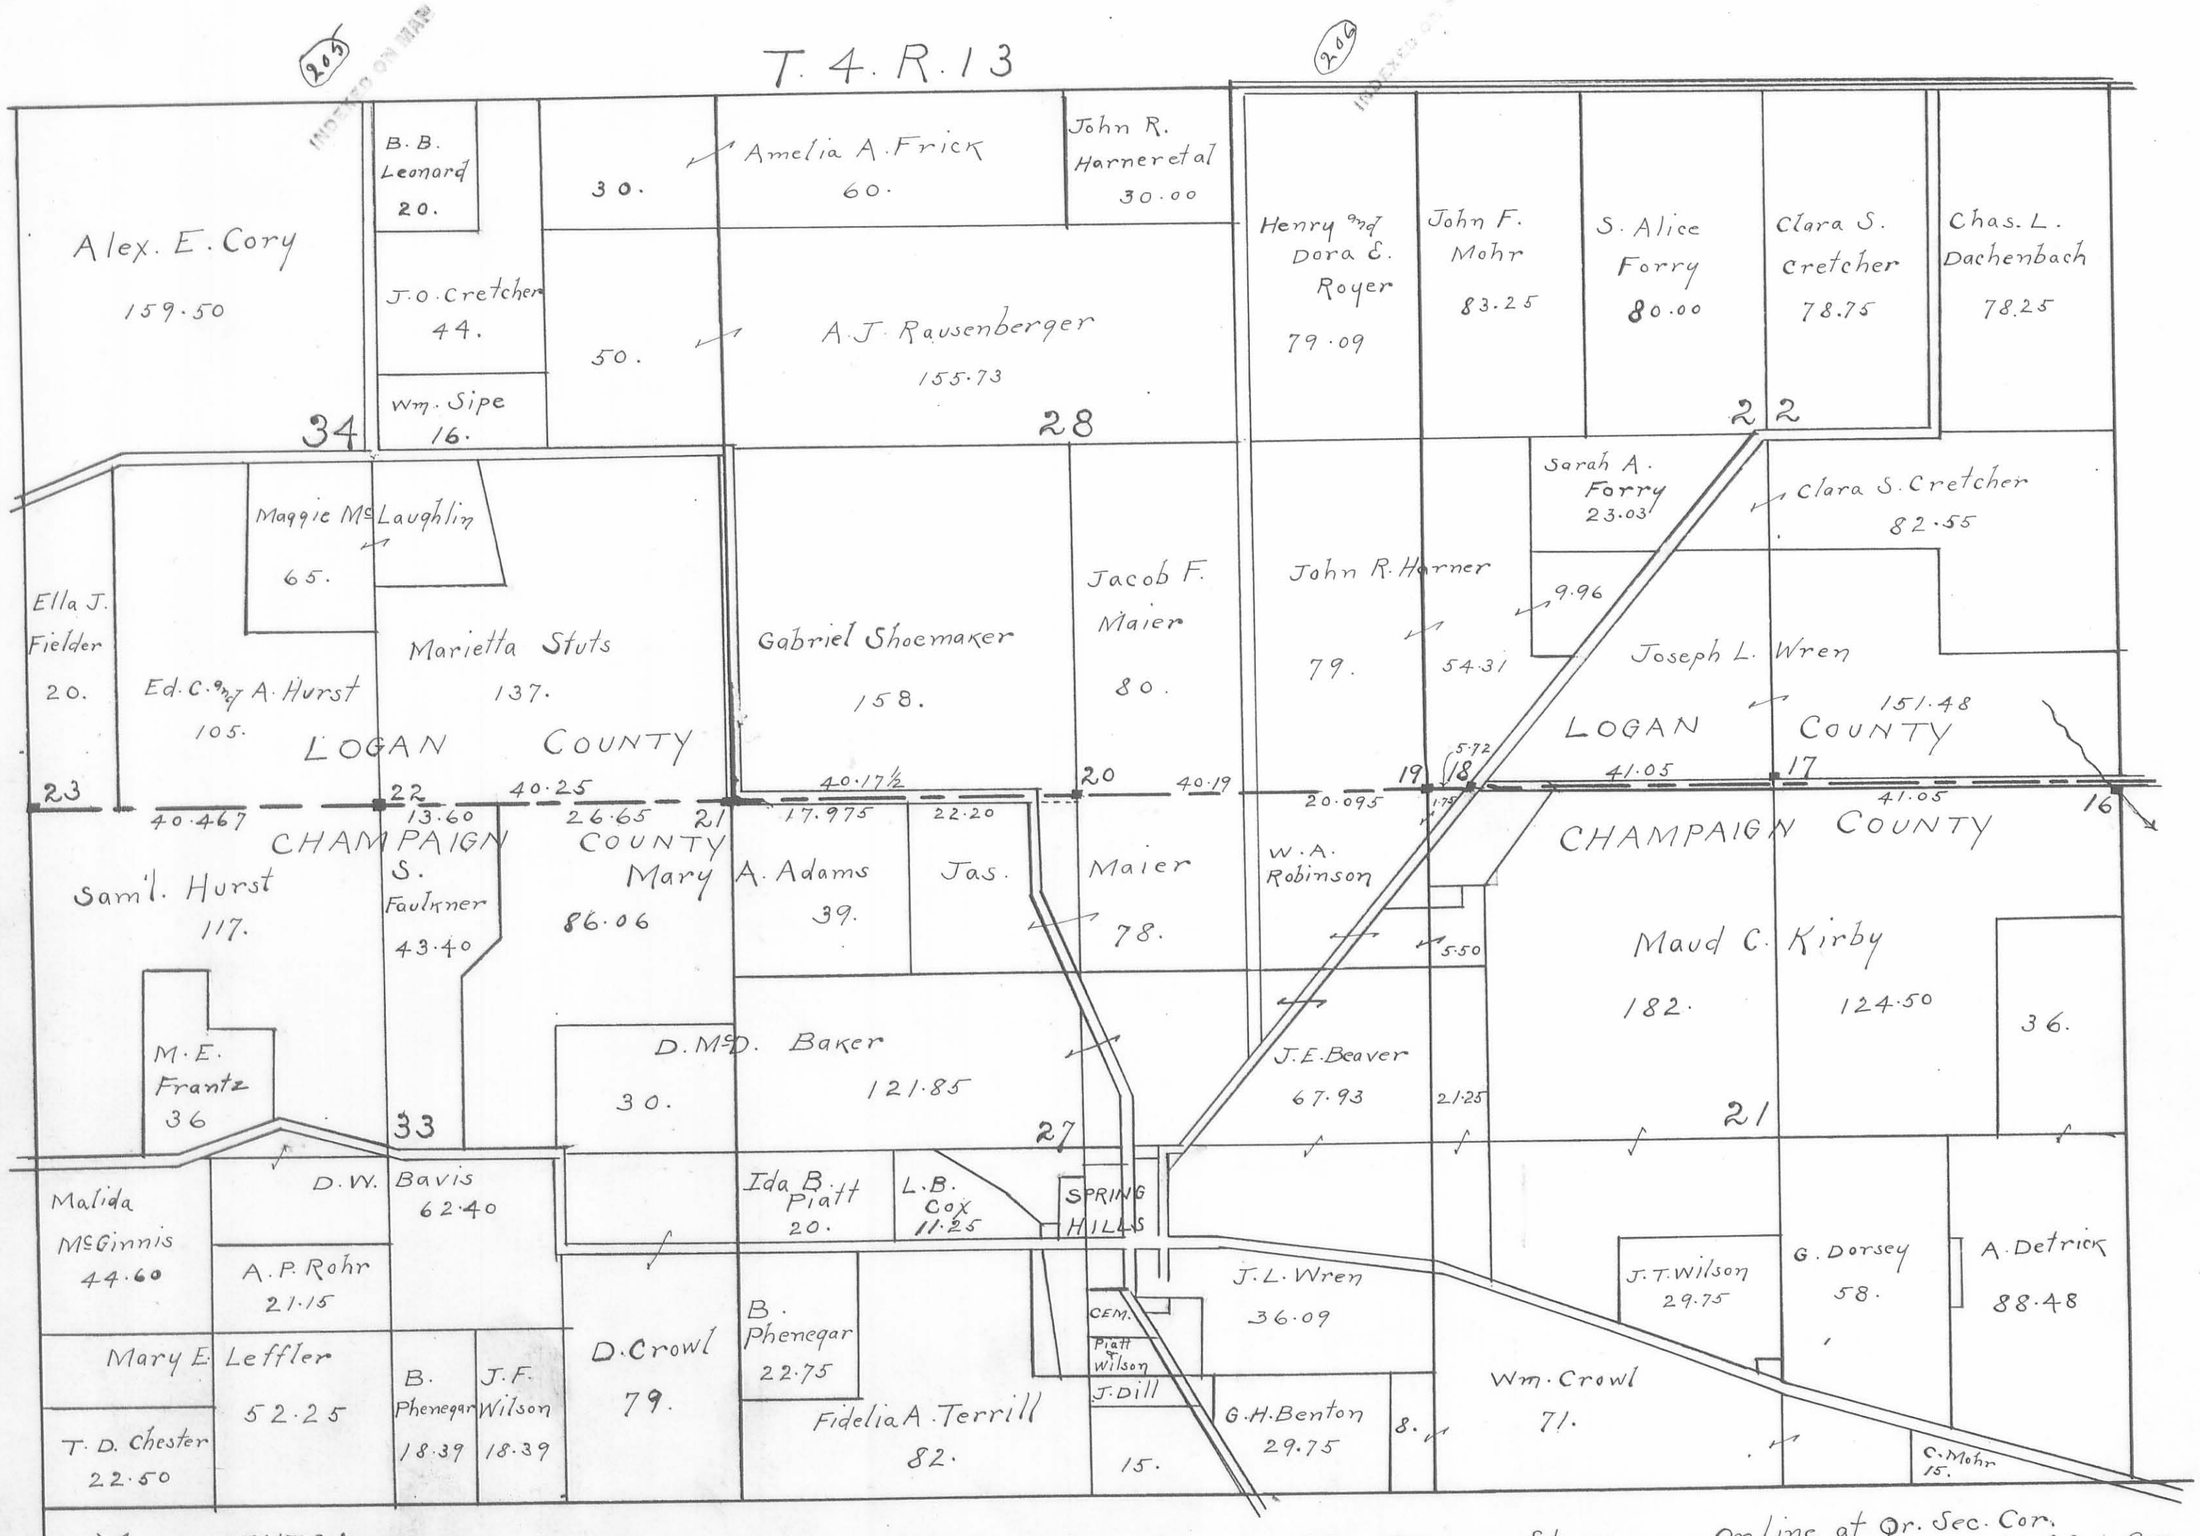

MONUMENTS:

No. 16 — Stone — 20 feet South, 20 feet West.
" 17 — " — 20 feet North of Qr. Sec. Cor.
" 18 — " — on line, west side Carlisle Road.
" 19 — " — on line at Sec. Cor.

No. 20 — Stone — on line at Qr. Sec. Cor.
" 21 — " — on line. 20 feet West of Sec. Cor.
" 22 — " — On line at Qr. Sec. Cor.
" 23 — " — On line and Cor. Adams and Harrison Tps.