


208 Ct. Blue Ash to 6th NW 35. Map to 10th 133 E 25 links -
 Benj^r Ellis, George Hill ch. men Dan Hopkins Sur. D. C.
 Nov. 20. 1835

N^o 258. 522. S. R. & E

(8337)

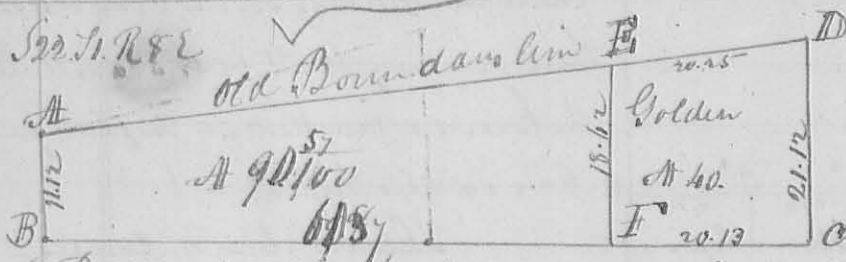

This plot represents
 the Survey & Sub. division
 of 522. S. R. & E. for Edward
 Timmons, as follows.

Beginning at the NW corner of the section. At old original
 corner down marked Ironwood 4 ch. ds. N 75° 13' E links, and
 Elm 30 P 81° E 9 links, then S 42° 11' E to the SW corner, the bearing
 tree down, then N 85° 3/4° E 81.00 to Red corner, bearing tree, tree
 down, then N 4 W. 21.12 to Back of 10th corner tree, as the boundary
 line, then with said line by 8 W to beginning, containing 130.37
 acres. Then cut off from east end of the foregoing survey, 40 acres
 for Golden. Begin at F. S 83° 3/4° W 20 ch. 12 links, from N E corner
 the section at a Back 10th N 68° E 28 links, 4 White Oaks 6th 186°
 W 27 links, then N 4 W 18.62 ch. to an Elm 24th 186° N 6 W 43 links,
 Swamp ash 20th 186° S 6 E 64 links, on the old boundary line -
 Nov. 21. 1835 Dan Hopkins, D. C. Surveyor

N^o 259

(8338)

Surveyed Dec. 10th 1834 for Mrs Rogan, the west half of the NW 1/4 of
 15th 1/2 of R 8 E. Lewis & Clark Reserve Beginning at the original post
 on the west line of the section, then N 86° 10' E 20 ch. 12 links, to Back
 15th 186° N 77° E 9 links, and a Beech 17th 186° 1/2 E 44 links, then S 35° E
 40²⁵ links, crossing the creek at 29 ch to Gray Ash 8th 186° N 4 W 2
 links, Beech Eye 4th 186° S 33 E 12 links, then S 86° 10' W 20 ch. 12 links
 to the NW corner of the section, then N 3° 50' W 40 ch. 25 links, to the
 beginning (an Ironwood 10th 186° W 3 links, Red Elm 6th 186° N 58 E
 22 links) containing 81. 3/4 acres.

H. Hopkins
 and Rogan } ch. men

Dan Hopkins, D. C. Surveyor

N^o 260

(8141)

Surveyed Dec. 12th 1834 for Bowyer & Sigell part of line of 079950
 Beginning at 2 White Oaks & Ash, N. E. corner to land surveyed
 by Mr Bowyer to John Harrod then N 12 W 22 poles, to 2 W. O. Sugar
 & Logwood, then N 78 E 42 1/2 poles, to 3 White O., then N 12 W 86 1/2
 poles, to 2 White Oaks, then S 78 W 162 1/2 poles, crossing a Big road
 at 12. & branch at 126 poles, to a stake in a prairie in the west