


Dec. ✓ 1835

13523
 N^o 301 Surveyed Dec. 16. 1835 for Michael Muffelman the follow-
 ing tract of land to wit Beginning at a stake from 3 poles
 from the South Easterly, comes to Lincoln McArthur's Survey
 N 10400 & 10179. thence N 87 E 126 poles, crossing Rush Creek at
 84 & small branch at 110 poles, to an Elm Ash & Gum, thence N 12 W
 138 poles, crossing Rush Creek at 118 poles, to an Elm & 2 oaks on
 black & gray, thence S 26 W 196 poles, crossing a bend of Rush Creek
 at 104 poles, to the beginning containing 27.16 acres.
 M. Muffelman }
 J. Muffelman } ch. con.
 D. Hopkins S. G.

8364
 N^o 302 A part of N^o 4493 Surveyed Dec. 21. 1835 for Land Sturtevant
 Beginning at a Crab Apple bush in
 the edge of a prairie, thence S 70 W
 134 poles, crossing a big road & small
 branch several times, to a stake on the
 top of a ridge near a hickory &
 small Jack Oak stub, thence N 38 E
 93 poles, to small W. & 66. Oak.
 thence N 67 E 121 poles, crossing the big road a small river stream
 to a stake in a bunch of willows on the bank of the river, thence
 N 20 W 89 poles, crossing the river twice to the beginning. Con-
 taining 78 acres 60 hundredths.
 L. Sturtevant }
 Derby, Survey } ch. con.
 D. Hopkins S. G.

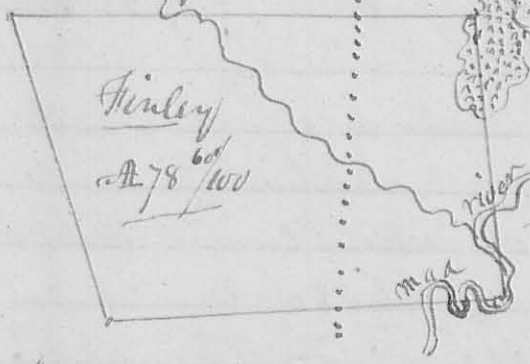

8365
 N^o 303 Surveyed for George Sturtevant
 Jan'y 22. 1836. Begin-
 ning at a stake in
 thence S 55 E poles, thence
 N 73 W 112 poles, to a
 stake in Big road.
 thence West 282 poles, thence North 50 poles
 thence East 147 poles, to begining, branch at 126 poles.
 D. Hopkins S. G.

