


Road 123

9-19-56

6

N 24° 50' W

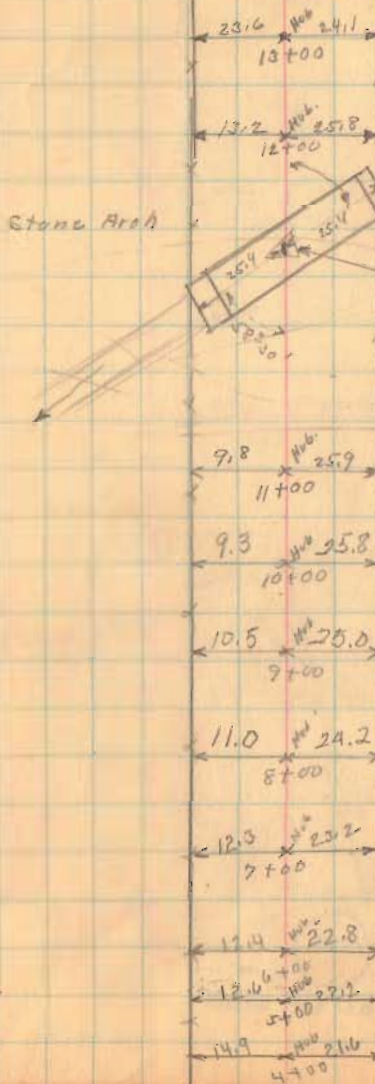

Small Hub
11+35
12-36' Right
Bridge
178-1.00

1743

INDEXED ON MAP

Road. 128

1743

INDEXED ON MAP

M10:91X

16.4 13.0 9-15-36

31+00 17.9 12.2

30+00 18.9 14.0

29+00 19.3 14.2

28+00 19.9 13.7

27+00 18.2

26+00 19.7 20.0

25+00 20.6 20.4

24+00 21.0 25.2

23+00 22.2 23.9

22+00 22.8 22.3

26+6.3 Hub
0° 07' Right

V.B. Hartzler
Road Post
Oscar Valley

Road 178

N. 10-91N

Rosa Willets


36+77

W. F. Lyle

No Fence

12.2
36+00

2 35+21

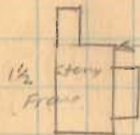83.6
35+01

No Fence

LAND 30442

2 33+16

14.2
33+00Shed
32+6515.0
32+00

1740

INDEXED ON MAP

Road 178

length 4538 Feet
length ~~4629~~ 0.8594695 Miles
length 0.86 Miles

1743

INDEXED ON MAP

9-15-36

10

