



# Paul R. Clapsaddle & Associates

REGISTERED ENGINEERS AND SURVEYORS

19019 WEST DARBY ROAD, MARYSVILLE, OHIO 43040, (513) 747-2599

## SURVEY FOR PAUL A. CHAMBERLAIN

0.36 Acre

April 1, 1981

The following described tract of land is situated in the State of Ohio, County of Logan, Township of Perry, Village of East Liberty, V.M.S. # 4689, being Lot 4 and part of Lot 3 of the PLAT OF THE TOWN OF EAST LIBERTY as recorded March 14, 1834 in the office of the Logan County Recorder, being all of Paul A. Chamberlain's 29 poles (square poles) tract described in Deed Volume 370, Page 351 and all of Paul A. Chamberlain's 7720 square feet tract described in Deed Volume 201, Page 424, being more particularly described as follows:

Beginning at an iron pin set at the northeast corner of said Lot 4, being in the south line of a  $16\frac{1}{2}$  feet wide alley and in the west line of Main Street (80 feet wide), said iron pin marking the principal place of beginning;

thence South  $20^{\circ}00'$  East (assumed bearing) 81.90 feet, following the east line of said Lot 4 and said Lot 3 and west line of Main Street, to an iron pin set and being South  $70^{\circ}03'$  West 3.65 feet from an iron pipe found;

thence South  $70^{\circ}03'$  West 192.00 feet, through said Lot 3, to an iron pin set in the west line of said Lot 3 and being in the east line of a  $16\frac{1}{2}$  feet wide alley;

thence North  $20^{\circ}00'$  West 81.73 feet, following the east line of said alley and west line of said Lot 3 and Lot 4, to an iron pin set in the south line of a  $16\frac{1}{2}$  feet wide alley;

thence North  $70^{\circ}00'$  East 192.00 feet, following the south line of said  $16\frac{1}{2}$  feet wide alley and north line of said Lot 4, to the principal place of beginning, containing 0.36 acre, more or less, and subject to all valid easements or restrictions of record.

The above description was prepared from a survey completed in March of 1981 by Paul R. Clapsaddle P.S. # 6140.

ATTEST: Paul R. Clapsaddle P.S. # 6140

6620 ID


INDEXED ON MAP



# Paul R. Clapsaddle & Associates

REGISTERED ENGINEERS AND SURVEYORS

19019 WEST DARBY ROAD, MARYSVILLE, OHIO 43040, (513) 747-2599

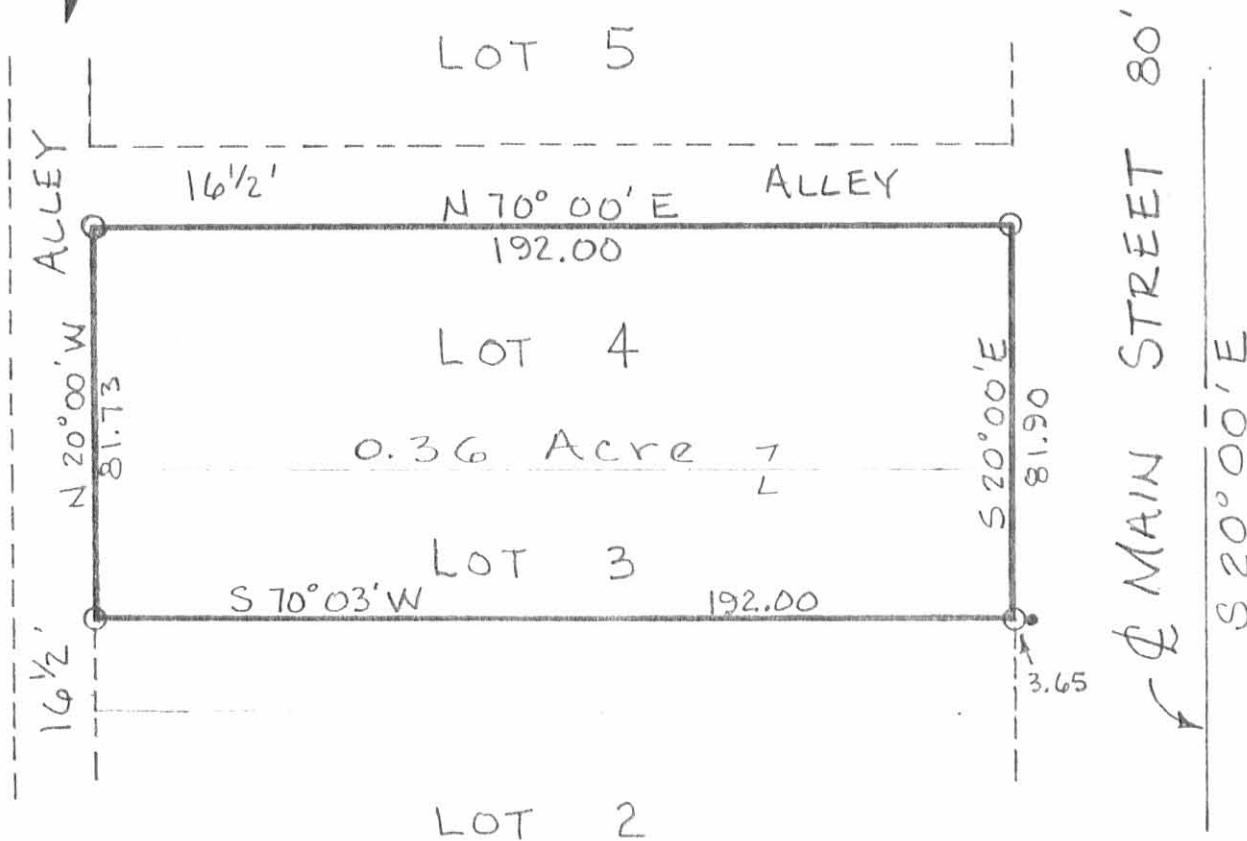

SURVEY FOR PAUL A. CHAMBERLAIN

State of Ohio  
 County of Logan  
 Township of Perry, V.M.S. 4689  
 Village of East Liberty  
 All of Lot 4 and the North  
 part of Lot 3 of the  
 PLAT OF THE TOWN OF  
 EAST LIBERTY recorded  
 March 14, 1834

SCALE 1" = 40'

DATE April 1, 1981

○ IRON PIN SET

6620 IP

INDEXED ON MAP

Paul R. Clapsaddle P.S. #6140

