Shelby Co

Sec No. 17 T. 1 R. 8.

Line A. Start at stone B for wit see line A Sec 20
Thence with road N 1 3/4 W
At 40.20 ch line fence fence Pool & S A Bell
" 60.27 ch line Bell and Lambert
" 80.44 ch N E ∠ Sec 17 at S side line fence running west, set side stake west 25 links, Variation west 3 links

---

Line B Start cent road at E = N E ∠ Sec 17
S 87 3/4 W (Trial line) at 40.04½ ch stone ∠ a
1 Half sec 17 Strike south of ∠ stone 38 links
Variation too much south 38 lks = ½° Ok see S 88 1/4 W
Set stake in Co line N W ∠ P.H. Lambert at
20.02 ch from ∠ E. Wit Beech 18" N 4 1/4 W 24½ lks
also R.O. 8" S 48½ E 3½ links

Robt. Smith has 30a.
Set monument for Co line at corner x being
from E S 88 1/4 W 20.02 ch for wit see above
Beech & RO Monument marked as follows

N side = S. 8. T 1. R. 8. S. side { S. 17. / 1884
E side Logan W side Shelby

Sec No. 17 T 1. R. 8

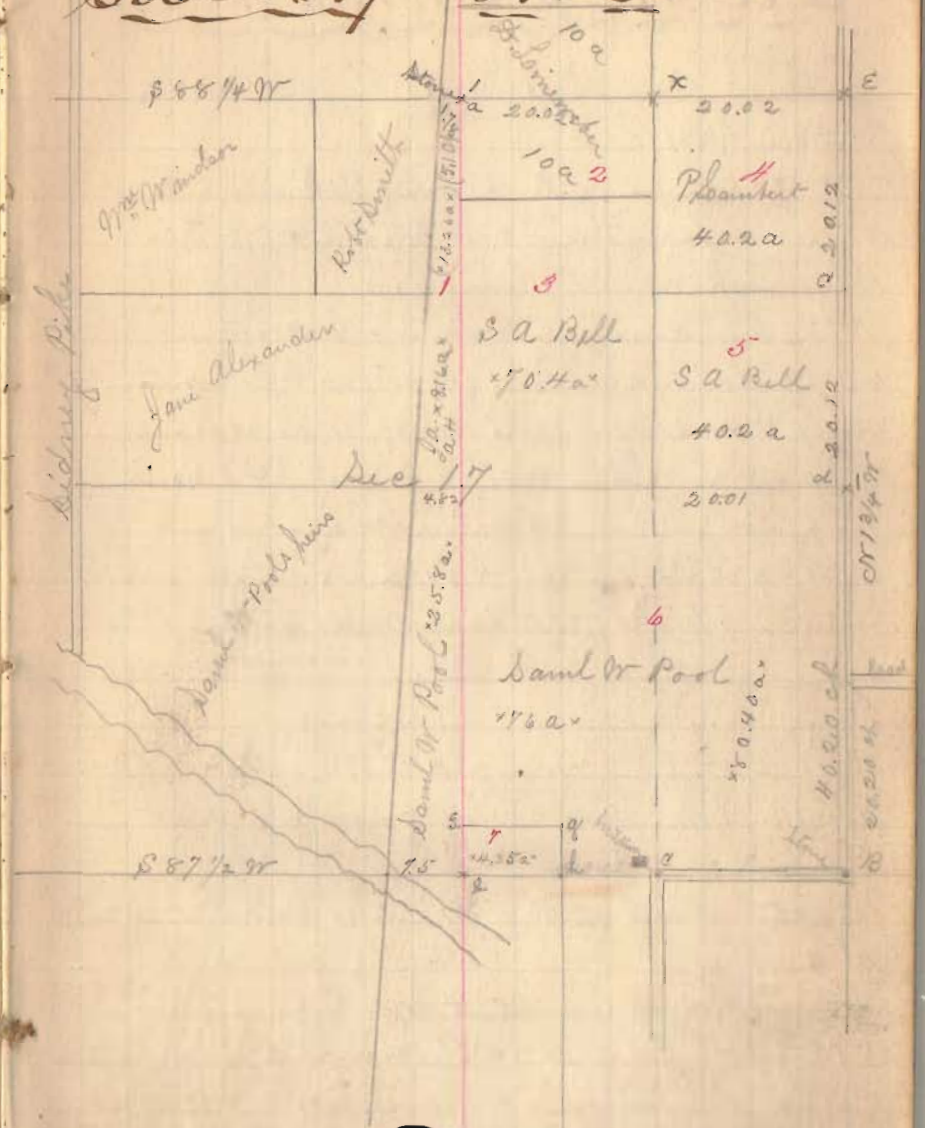

340

INDEXED ON MAP