

- LEGEND**
- 5/8" IRON ROD FOUND
 - 1" SQUARE IRON BAR FOUND
 - ⊙ 1" IRON ROD FOUND
 - ▨ VACATED STREET OR ALLEY

REFERENCES

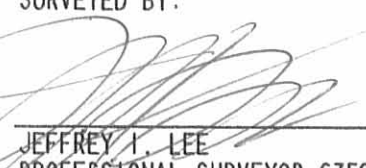
PLAT OF LOGANSVILLE,
SURVEY BOOK 4, PAGE 137

LOGAN COUNTY ENGINEER FILES:
R-6529, R-6973, R-8884, R-9086

RESOLUTION NO. 384-92
ALLEY VACATION

RESOLUTION NO. 456-92,
STREET AND ALLEY VACATION

RETRACEMENT SURVEY OF THE
MARILYN V. CAREY
ORIGINAL LOTS 35 AND 36
OFFICIAL RECORDS 57, PAGE 613
VILLAGE OF LOGANSVILLE
PLEASANT TOWNSHIP
LOGAN COUNTY, OHIO

SURVEYED BY:

JEFFREY I. LEE
PROFESSIONAL SURVEYOR 6359
MARCH 5, 1998



ORIGINAL STAMP IN GREEN

2 WORKING DAYS
BEFORE YOU DIG
CALL TOLL FREE **800-362-2764**
OHIO UTILITIES PROTECTION SERVICE.

INDEXED ON CAP
6529 1P

COPYRIGHT 1998 BY:
LEE SURVEYING & MAPPING CO., INC.
117 North Madriver Street
BELLEFONTAINE, OHIO 43311
(937) 593-7335

O.K.S Book
Page 10

Logansville

Oct., 1965

101

