No. 234

(8318)

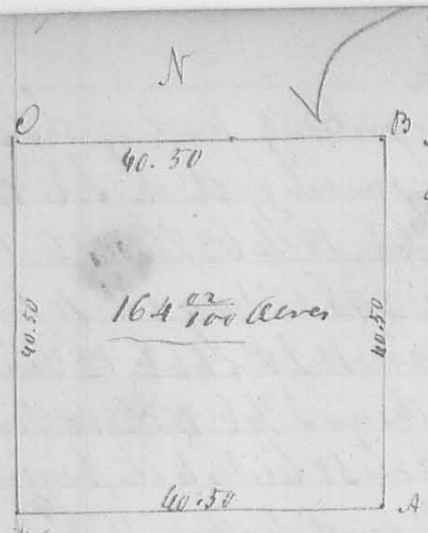

This Plat represents the NW qr. of Sq 12 R 14 W 5th Surveyed for James Stock Jany 16th 1834. beginning at a W. O Stump 0 82 D South 9 Links and W. O. the 18 D N 42 W 31 Links. in terin corner representing A on the plat. thence North 40 ch. 50 Links to Jno Rogers S. E corner. thence West 40 ch 50 Links to the NW Corner of the Section. then South 40 ch. 50 Links to a Cherry 2 D N 75 W 6 Links and a Cherry 2 D S 22 E 11½ Links then East 40 ch. 50 Links to the beginning Containing 164 02/100 acres

Lewis & James Stock ch. carriers — D Hopkins Surveyor.

No. 235

(8319)

This plat represents the plat division of S S 12 R 14 W 5th Surveyed Feby 5. 1834 for Adam Moore Wm Price & David Downs beginning as above at the NW Corner of the Section, thence with the course and distances as marked on the lines from A to B. & the division lines running parallel to the Section lines varying so as to close. the description of the corners as follows: A. NW corner of the Section. B. Stake in prairie. C. White Oak 22 D S 36 W 60 Links. White Oak 12 D N 76 E 78 Links. a Stump plain. E Stake in prairie. F Stake in prairie - h. White Oak 22 D S 14 W 18 Links. D. 22 D S 45 E 28 Links - k. White Oak 8 D S 54 W 21 Links. D. 12 D N 76 E 78 Links. L. White Oak 36 D West 34½ Links Hickory 18 D N 34 E 39 Links - M. Hickory 18 D N 17 E 70 Links - Black Oak 18 D. S 2 E 34 Links - The orig. corner here is not to be found - John Moore Alfred Matthews ch. D Hopkins Surr.

No. 236

(8320)

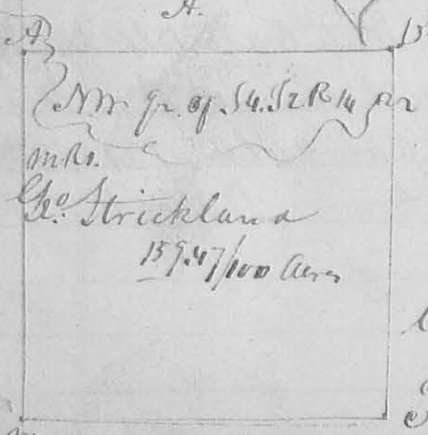

B. Surveyed as follows, beginning at NW corner of the Section then S W 39.50 ch. to orig. qr S. Corner. then S 87½ E. 40 ch. to Stake. come to John & Dennis Moore - then N ¾ E. 40 ch to a Stake in a prairie. then with the North line of said Section West 40.18 to the beginning Containing 157 47/100 Acres

Wm Price David Deardorff ch. D Hopkins Sur.

Feby 7. 1834