O. R. Dock Survey April 4 - 1916
Piqua Ohio a fine mild day.

R. P. STUDLEY & Co., Manufacturing

STATION.	ALIGNMENT.	DEFLECTION.	REMARKS.

(1) Start at stone in cent Miami St E/ New St west.

Thence N on cent Miami St.

at 335.5 Stone cent Miami E/ South St

(2) Start at stone (fine stone about 2" x 10" wedge) + mark on top. Thence E. on cent South St

at 24.75 = Spike Miami St. E/S 33' to NW ∠ lot 73. at 90.75 & line lot 73 E/S 33' to NW ∠ lot 73

(3) Start at stone cent Miami St E/ South St

South on cent Miami St

at 33' Spike South St. E/ East 24.75' to NW ∠ lot 73. cut + in cement side walk at NW ∠ lot 73. Ring about 8" N E/S" W of NW ∠ Brick building

at 63' pathline of 30' off N end lot 73 E/ East 24.75' cut + in cement side walk

at 165' N line of 10' alley. E/ E. 24.75' to E. NW ∠ lot 73. cut + in cement side walk E/ E. 90.75' above spike in telephone pole. = ∠ line lot 73.

Iron stake (Piece of Iron Handle) at S E ∠ of 30' of N. end of lot 73.

(4) Start at stone cent Miami St E/ South St

Thence N on cent Miami St

at 33' cut 60 d spike, at 165' cut 60 d spike

(5) Start at spike 33' of (4). W on Spike South St

at 90.75' W line lot 89. at 140.25' E line of 16½' off W side lot 88 + on side walk

at 189.75' W. line of 33' off E side lot 87 + cut in side walk

(6) Start at spike 165' of (4) Thence W on S side alley

at 140.25' E line 16½' off W side lot 88 cut small stake

" 189.75' W. line of 33' off E side lot 87. cut small stake

Piqua O. Survey Feet 50 / 49.5' = 24.75'
" " 87
" " 49

Miami St = 33' = 49½'
South " = 24" = 66'
alleys 1" = 16½'

TOPOGRAPHY.

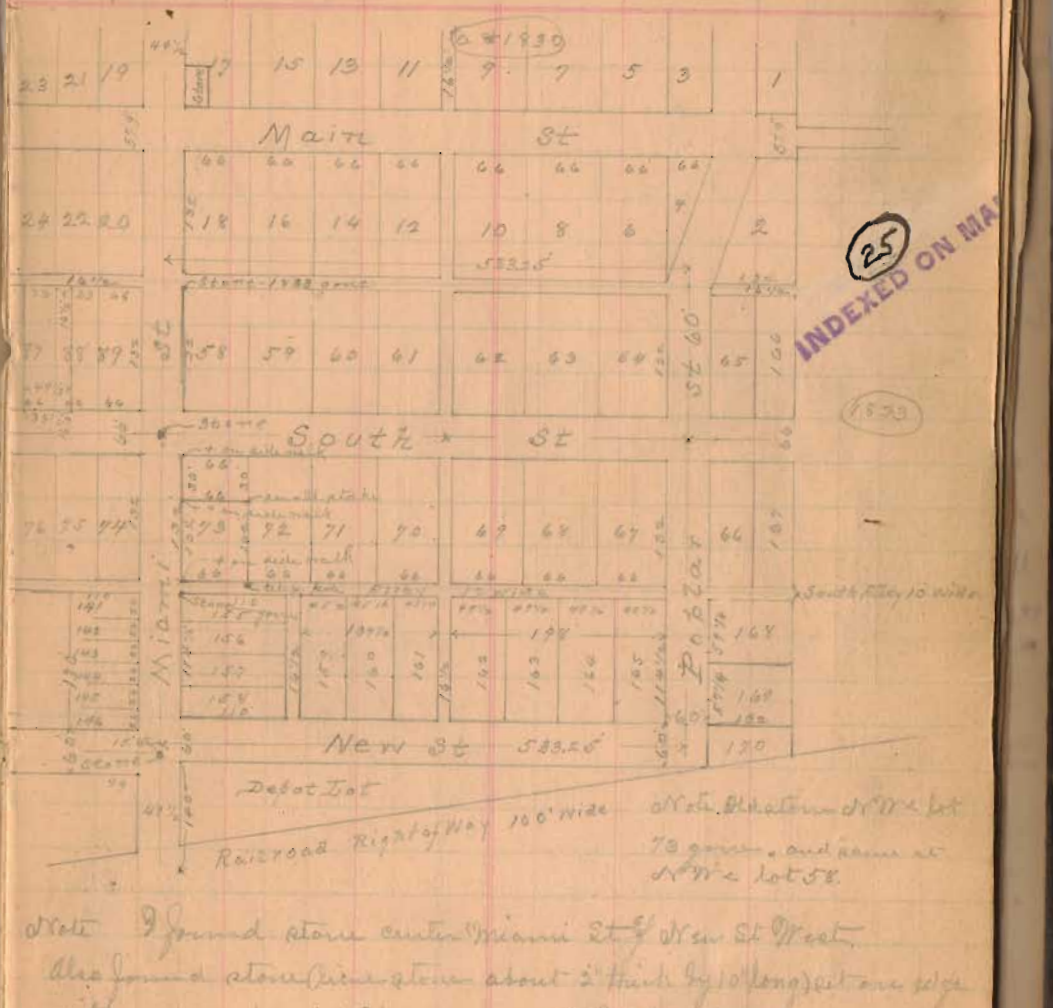

Note Found stone cent Miami St E/ New St West. Also found stone (fine stone about 2" thick by 10" long) set on edge with a + mark on it E/ same was set by previous surveyor for center of Miami St E/ South St. but it is 6" too far north to suit the occupation of lots 89 & 74 on South street. Also the S E ∠ lot 89 E/ of N E ∠ lot 74 stand old 2 story frame buildings which are just 66' apart measured across South St. E/ I considered these 2 old buildings as better monuments for finding cent of South street than the stone but set corners E of Miami St pursuant to agreement, as I used it