Survey for W. C. Huston
V.M.S 14032, Richland TWP.

Aug. 1930
J.S. Crane
Wm. Fultz

A. 2" lime stone found
B Post
C Post
D Iron Bar set
E " " "
F Post
G Post
H. Iron Bar set.
I " " found at intersection of Ellistown Pike

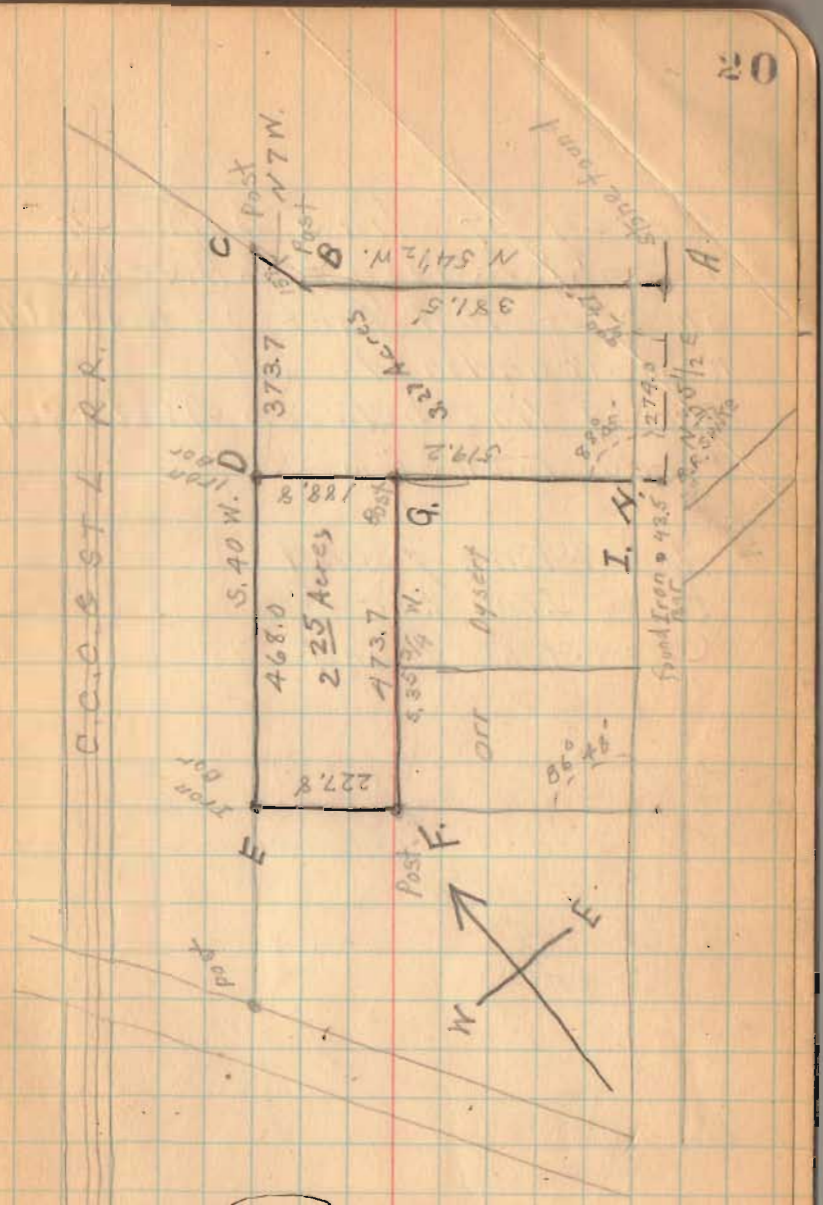

(1215)
INDEXED ON MAP