Surveys Recorded

N° 416 Surveyed

(8431) Surveyed April 30. 1838 for Daniel K. Goforth part of Military Survey N° 9989. Beginning at an Ash. South East Corner to the original Survey (also a Beech) thence N 11½ W 100 poles to a Large Ash; thence S 78½ W 80 poles to a Beech & Sugar thence S 11½ E 98 poles to a Stake, thence N 77½ E 80 poles to the beginning Containing 50 Acres.

Lan. McKim D.S. for L.C.O.

N° 417 Surveyed May 29. 1838 for Andrew Roberts part of Survey 9989. Beginning at a Sugar & Beech (Patent Call for a Stake) thence N 11½ W 200 poles crossing a Creek at 128 poles to 2 Sugars (now Oak down) being the Beginning Call of the Patent thence N 78½ E 105 poles Creek at 20 p.c to a Beech & Gum, the Gum down, thence S 10½ E 200 poles to a Beech thence S 78½ W 105 poles crossing run at 11 p.c, Creek at 45 & 60 poles to the beginning.

Lan. McKim D.S. for L.C.O.

N° 418 (8433)

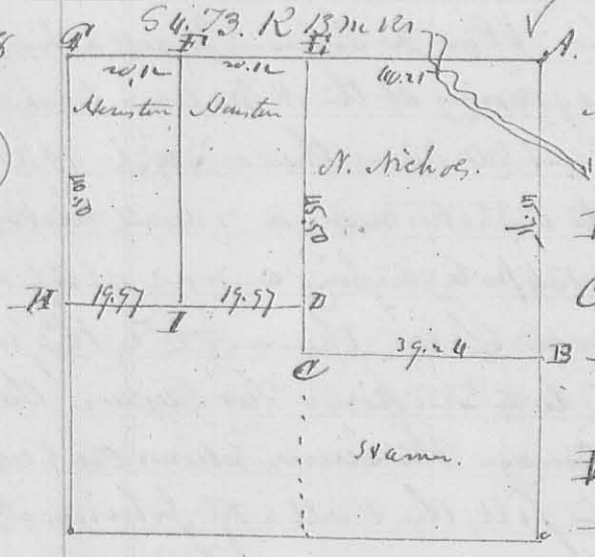

Corners.

A. Wh. Oak 12 L.D. N 68 W 30 Links
ditto 16 " " N 35 E 20 "
B Stone in a Drain.
C. Wh. Oak 20 L.D. N 80½ W 33. "
D Bl. Walnut 3 " " S 59 E 17½ "
" Bl Oak 8 " " N 37½ W 61 "
H ditto 12 " " N 58 E 50 "
— Hickory 15 " " N 17½ W 33 "
F Stake.

G Red Elm 5 L.D. South 27 Links. down and gone. (plenty stone)
Bl. Walnut 10 L.D. N 57 W 23 Links.

H Jack oak 6. S 48½ W 57 Links. Elm 12 L.D. N 80 E 61 Links (Stone)
D Stone & Wh. Oak 12. L.D. N 30½ E 57 Links an White O 15 L.D. N 61½ W 95
then Beginning at C. thence East ch to Stone & White oak 20 L.D.
N 13¾ E 75 Links. thence N 34½ E 16 ch to a Stone thence N 53¾ E 10.50 Links
to a Large Stone. thence N 45 W 7.88 ch to a Bl. Walnut 12 L.D. S 29 E
37 Links: thence on a Walnut 12 L.D. N 29 E 42 Links — thence