14
40

100.5
18.0
560.0
58.9
81.0
818.4

56.3
72.0
113.8
182.1
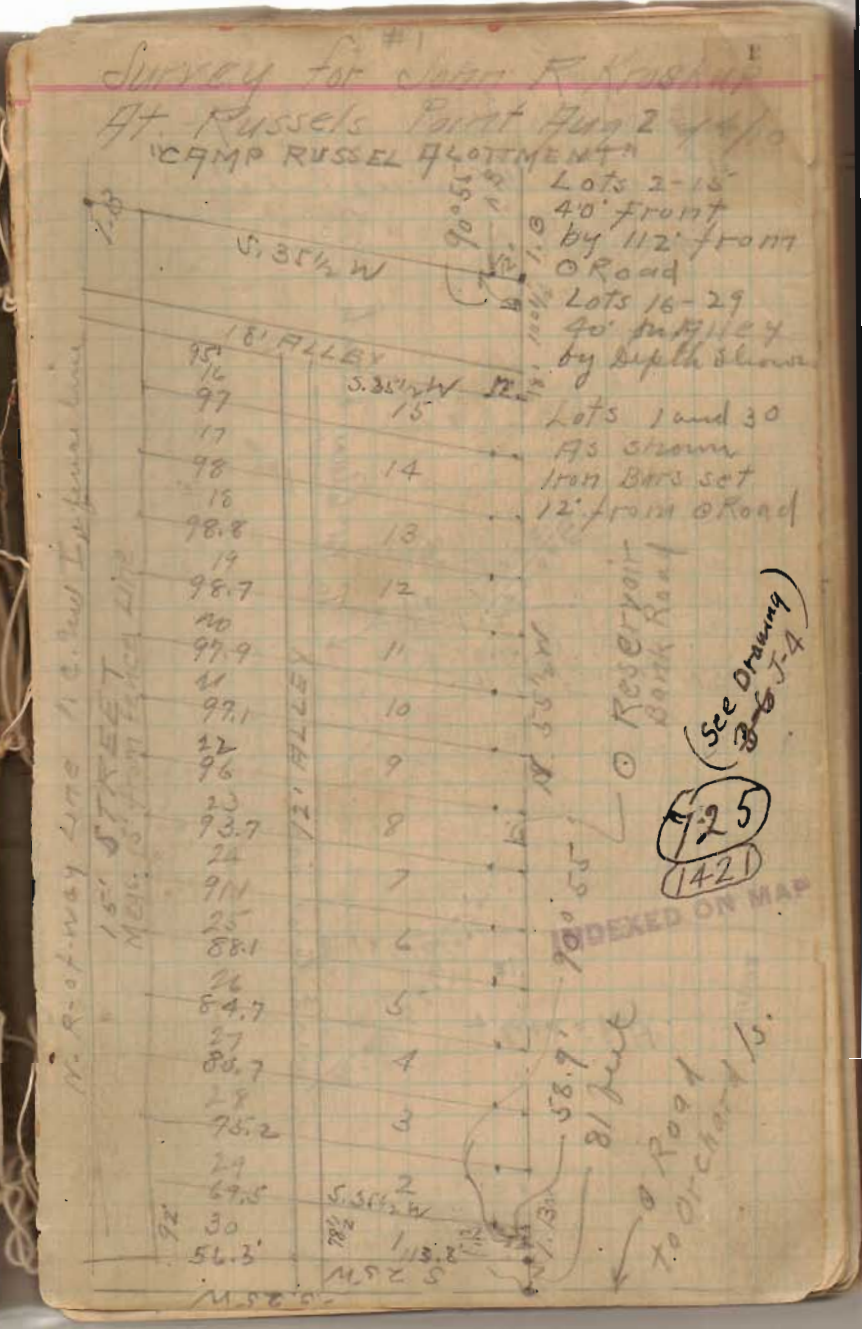
15
56.3
12
1138
198.1