Winnie Tait

Survey of Lot in Russells Pt

Measure NW along sidewalk on SW side SH 168

0+00 bolt in sidewalk — see note on opp page

0+60 cut in S. side of walk iron pipe on S side walk (found)

1+20 cut in S. side walk (found)

1+80 cut in S side walk (found)

2+40 cut in S side walk (found)

3+99 end of concrete walk and fence to Sourly

on fence line to rear of lots

0+00 pipe (found) SW cor Krouskop SE corner Werts on RotW line (and LE

3+43 pipe (found) corner to Kolte & Barr

Deeds call for 345

Short 2.00

Distributing of shortage 60.64
61.64
60.64
60.64
99.42
342.98

C Alnskeep
F L Horch

6/9/47

Job No 137

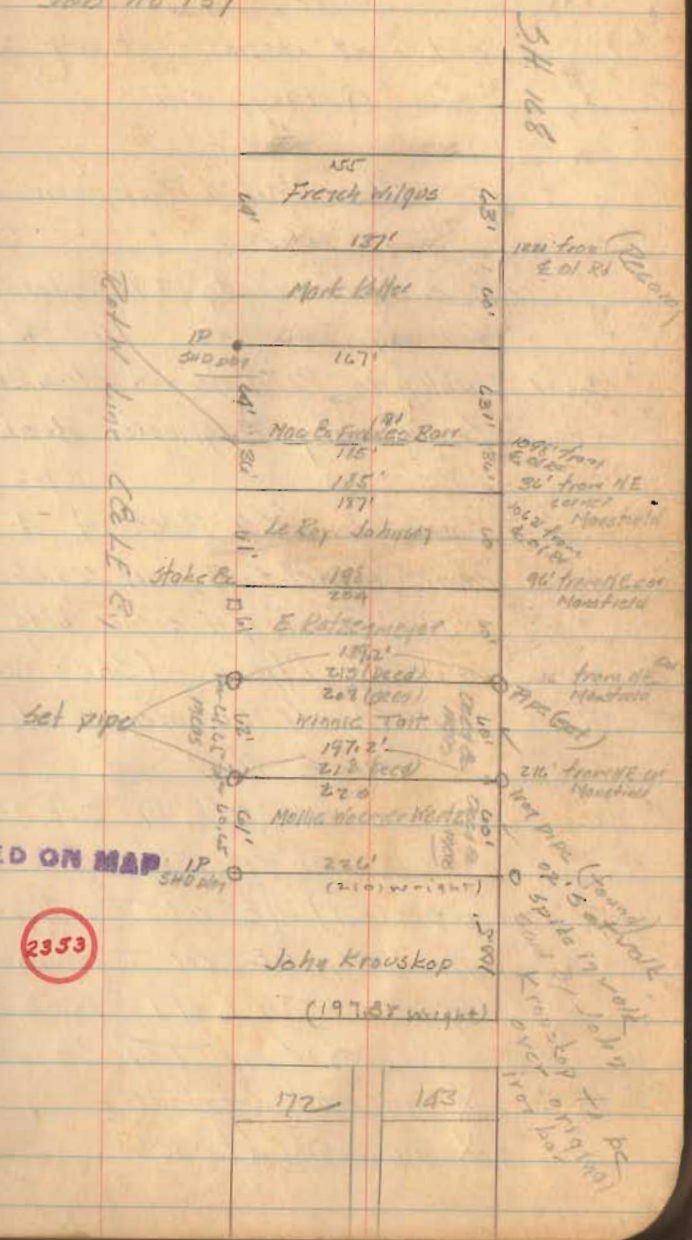

INDEXED ON MAP

2353