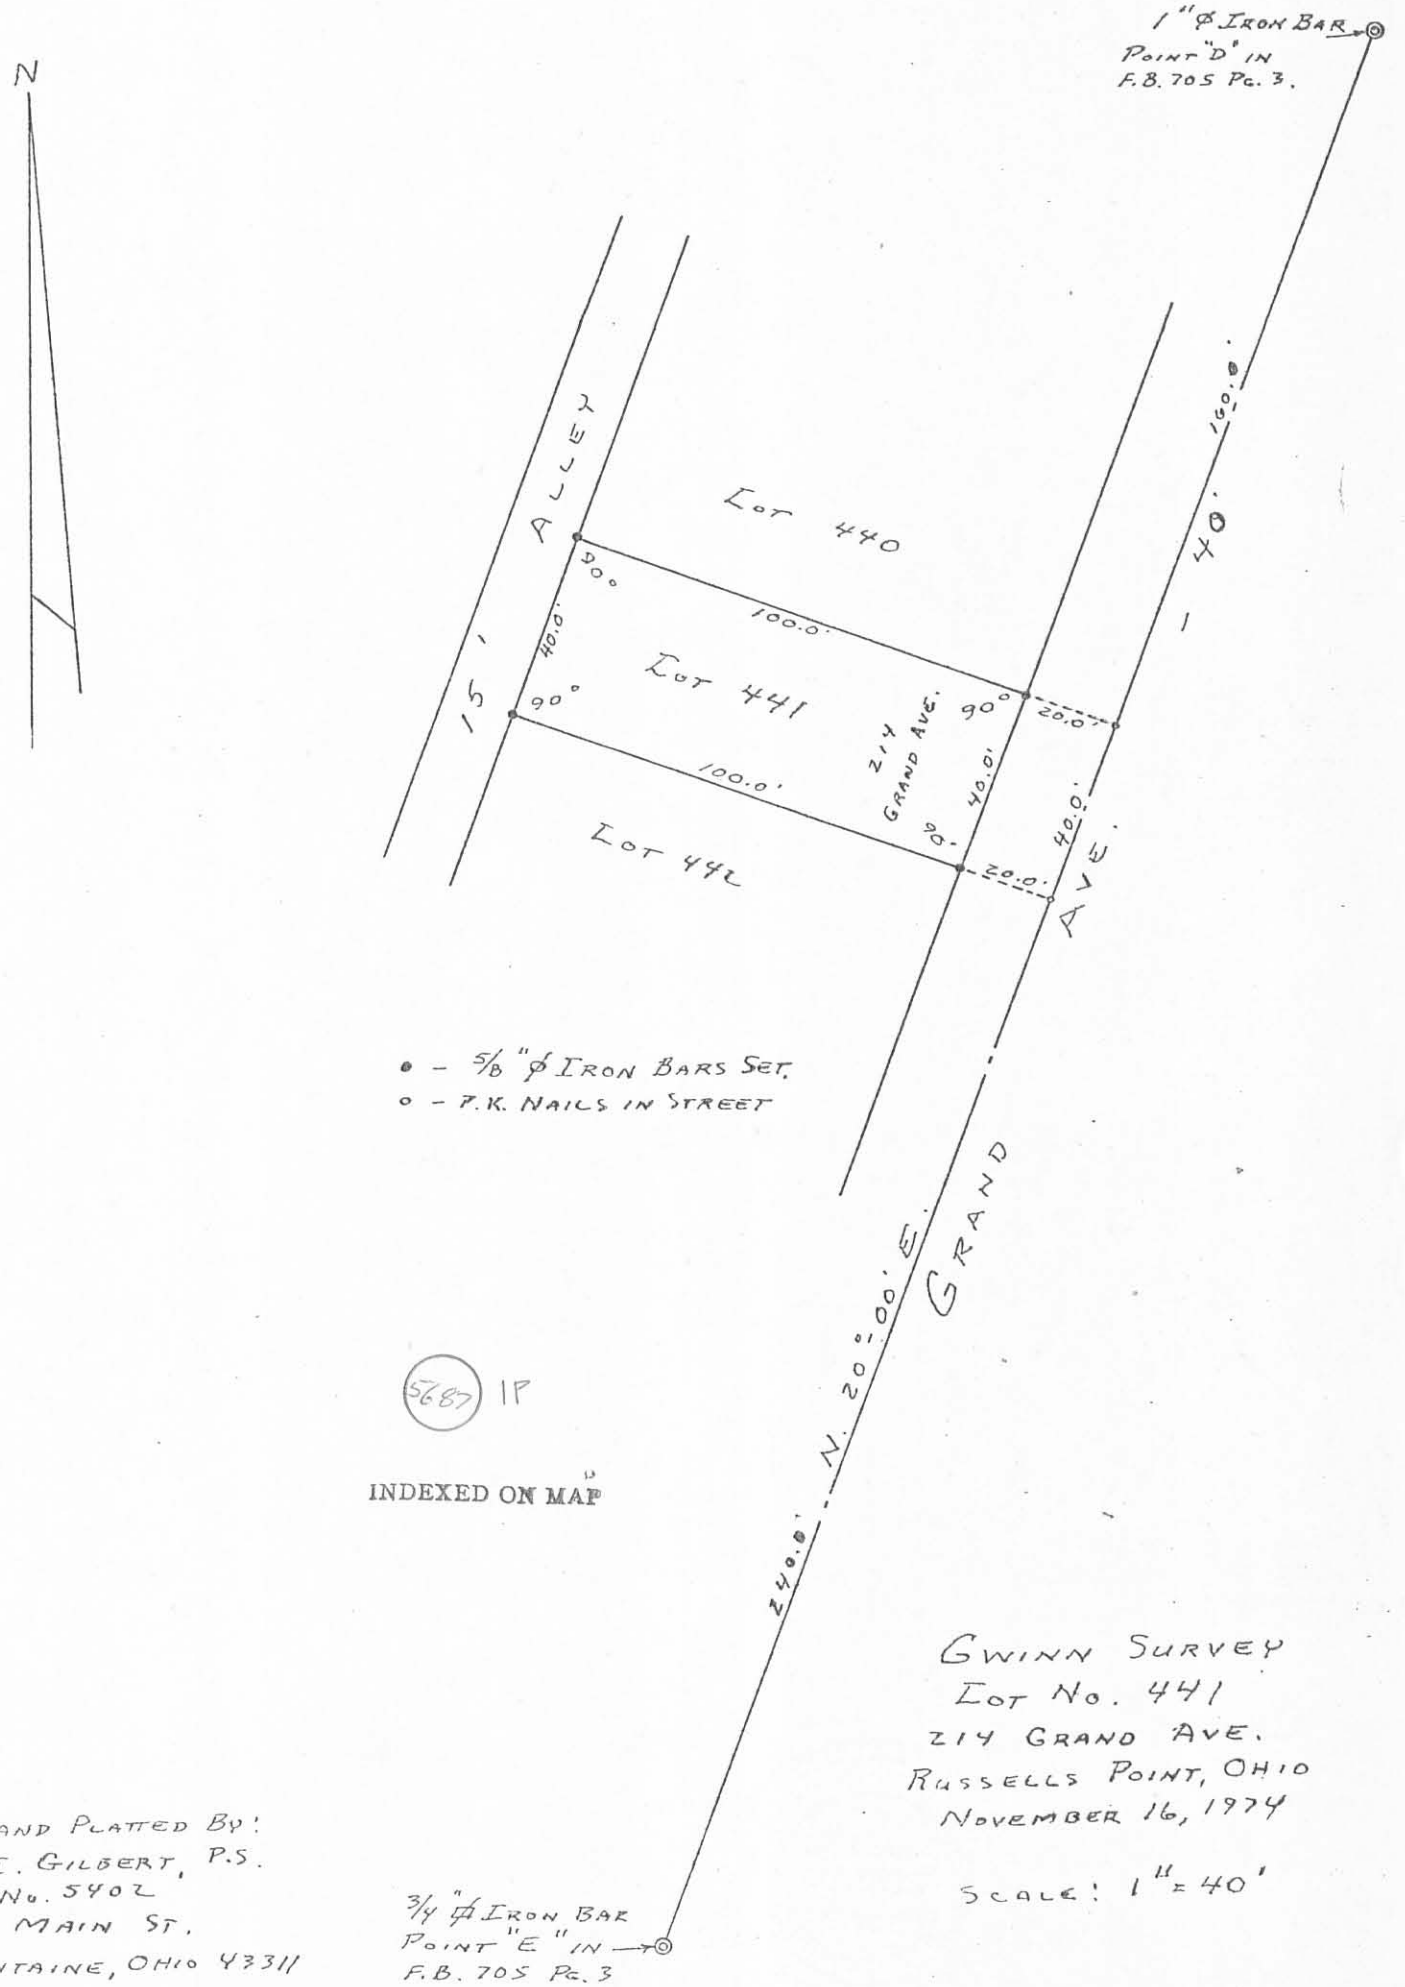

5687 1P

INDEXED ON MAP

GWINN SURVEY
LOT NO. 441
214 GRAND AVE.
RUSSELLS POINT, OHIO
NOVEMBER 16, 1974

SCALE: 1" = 40'

SURVEYED AND PLATTED BY:
DANIEL E. GILBERT, P.S.
REG. SUR. NO. 5902
1041 N. MAIN ST.
BELLEFONTAINE, OHIO 43311