June-19-1923
Mosby

Wright
Ed. Core.

Road Near Andrews Farm Stakes

Road #8

Note that Stone B is not in line between A & C. This is due about 3' from A.C. Sec. 7
& 15' from point fence.
No measurments were made between Stones.

See Road Survey Book 559 Page 6

137

INDEXED ON MAP
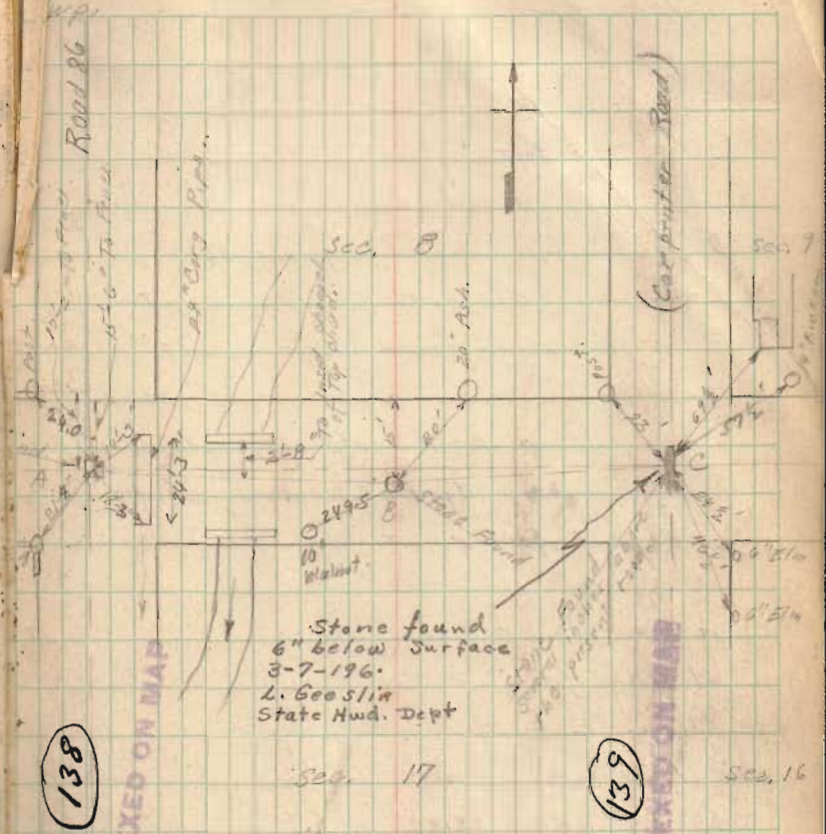
Sec. 18