

Road #52
Stakes TP.

Crane

A.M. Benick 1 1/2

Harold Taylor 1 1/2

May 23-30

" 26-30

Lunches


1.50 1.50

See Road Record No. 1 Page 370 for Map
45' Road.

Staked 50' Trustees Buying
additional Right-of-way

1315
INDEXED ON MAP.

53

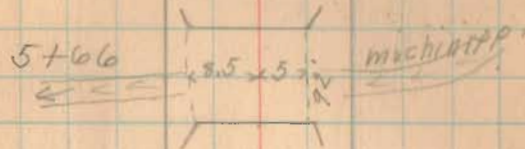

Sec. 5

Sec 32

See Book D Page 69

1+78. Moses A. Smith

Stone

P.L. Alexander 1+34

Moses A. Smith

25' 25'

Moses A. Smith
Road # 54

Sec. 4

sta. 0

Road 54
see Book D
Page 23

For Road 52
East. see Book
D Page 55 map

Road SW

15" Apple O 394 x 1/4 sec 28+16²
 Both F.M. Thompson
 125.0' O 20" Oak

26+77 Road # 53
 (see Book 518)

P.L. Alexander

25+70 drive

25' x 25'

F.M. Thompson
 14186² x x
 school

Slope

13+49 school x x
 Moses A. Smith

1315
 INDEXED ON MAP

9+41 0/110