Road No. 250
Stokes Twp
V.M.S. 12277

30' Road Record No. 1 Page 192
" " 191

See Plan P-24 Page 41
Stake placed 17'-6" from ℄ for 35' Road

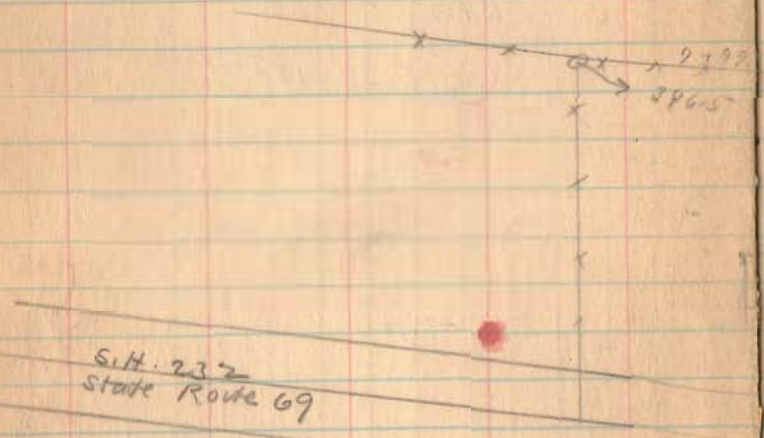
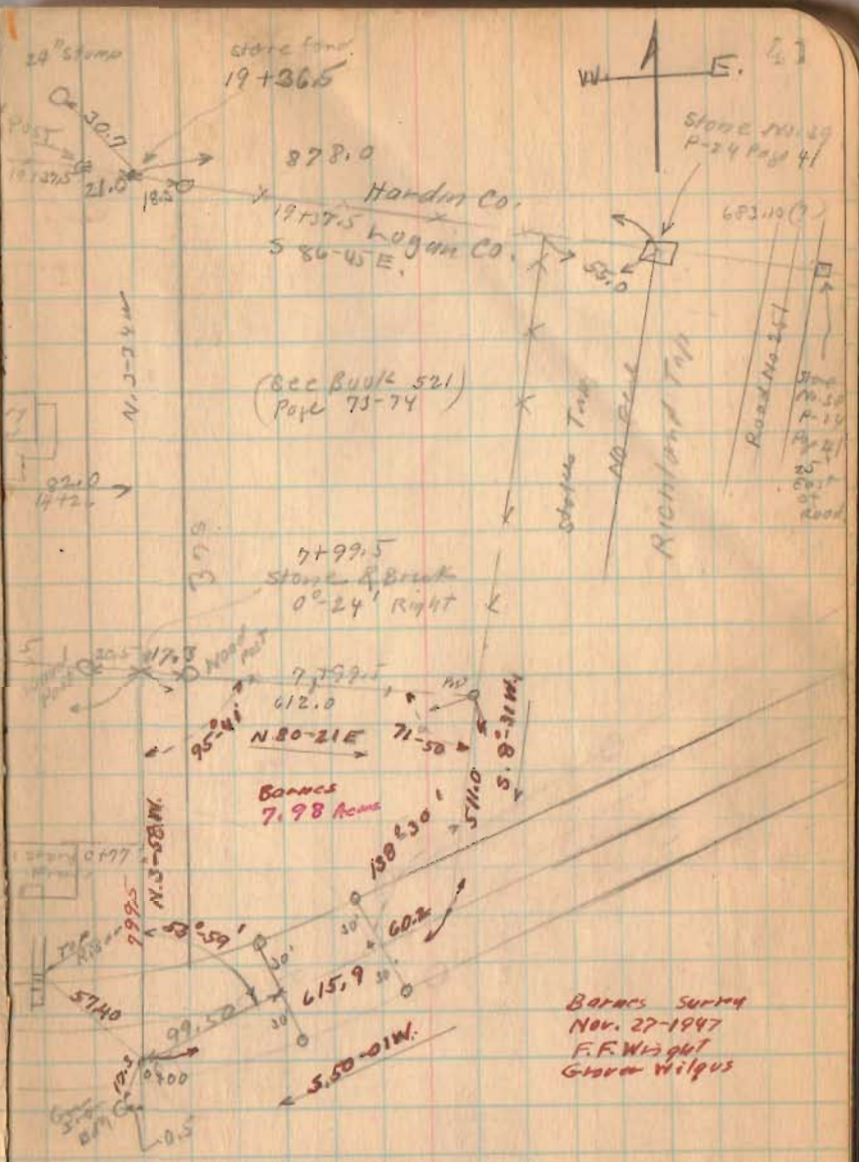
(1640)
INDEXED ON MAP