Hursh Survey

Lots 226-227-228 Wise Island View

V.M.S. 12276

Stokes Township

See	Survey	(1012)	Book 416 Page 45	Drawer B.
See	Survey	(628)	Book 418 Page 56	
See	Survey	(1249)	Book 572 Page 54	
See	Survey	(1023)	Drawer B	
See	Survey	(1487)	Drawer B	
See	Survey	(97)	Book 385 Page 36	

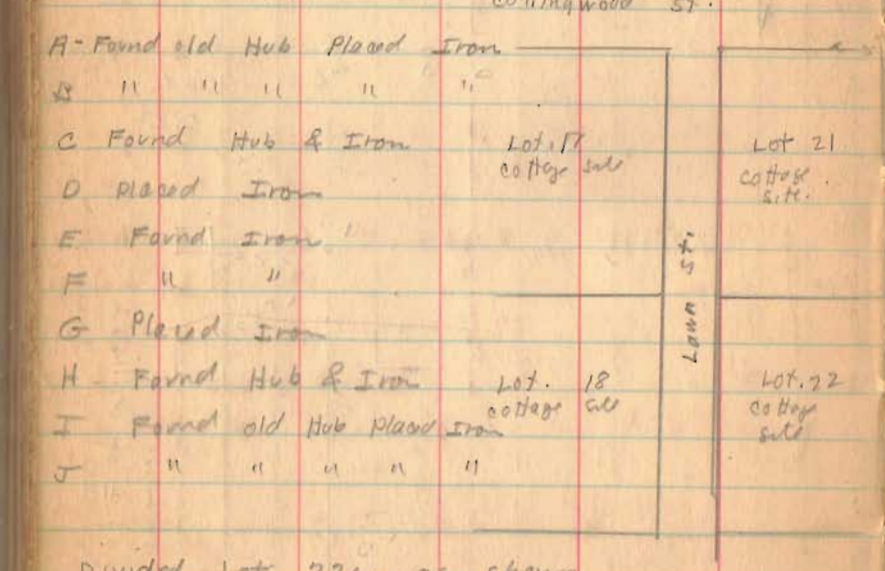

Divided Lot 226 as shown

(1684)

INDEXED ON MAP

Aug. - 31 - 1935
Nice day
F. Wardell
E. K. Co-e

71

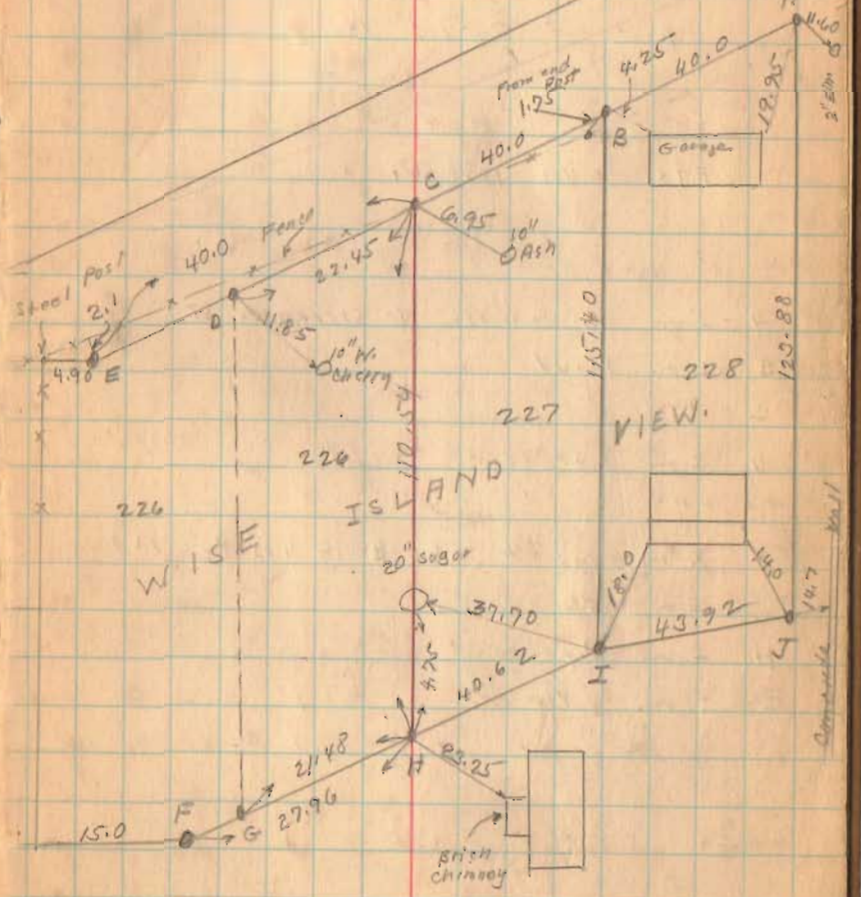

C.C. Hursh 202 - 15th Ave.
Middletown Ohio