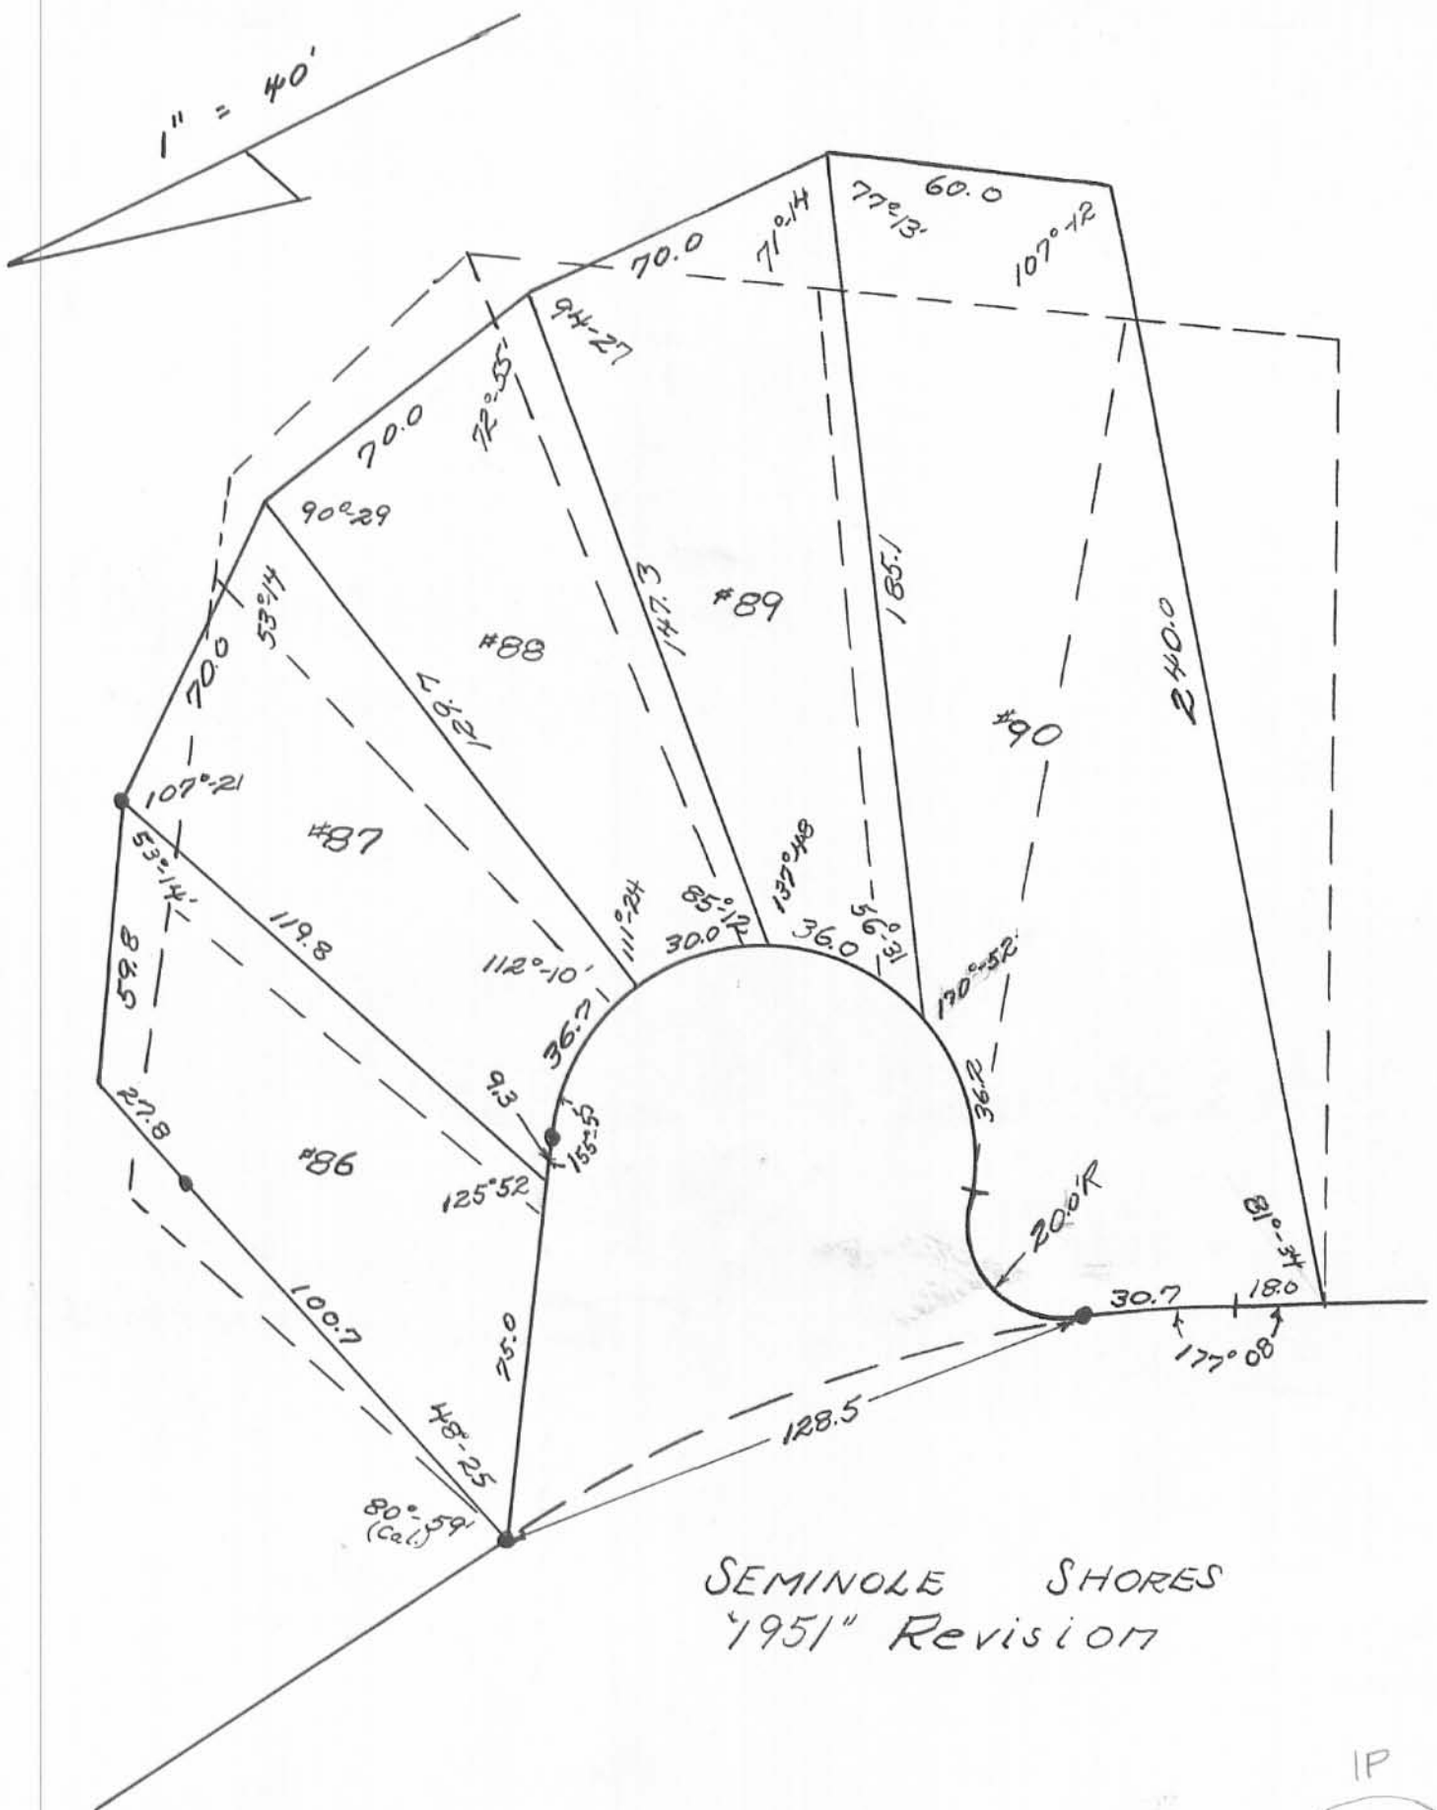

SEMINOLE SHORES
"1951" Revision

IP

4206