FB 704

July, 1965

Survey of
Cottonwood Avenue (15')
Wise Allotment of Island View
Stokes Township
Logan County, Ohio

A = 3/4" Pipe Fd. Replaced w/ 1" ⌀ bar
B = 3/4" Pipe Fd.
C = 3/4" Pipe Fd.
D = 1 1/2" Pipe Fd.
E = 1/2" ⌀ Bar Fd. (S. Side Oakwood Ave)
F = 3/4" Pipe Fd
G = 1 1/2" Pipe Fd.
H = Evidence of old hub (Replaced w/ 5/8" ⌀ Bar)
I = 1 1/2" Pipe Fd
J = Remains of old hub (Placed 5/8" ⌀ Bar Over)
K = 1" Pipe Fd.
L = 1" ⌀ Bar Set
M = 1" ⌀ Bar Fd.
N = 1" ⌀ Bar Fd.
P = 1" ⌀ Bar Fd. (S. Edge on Line IJL)
Q = 1" Pipe Fd.

L. Geeslin & J. Slater
J. Cox
P. Kaucher

1

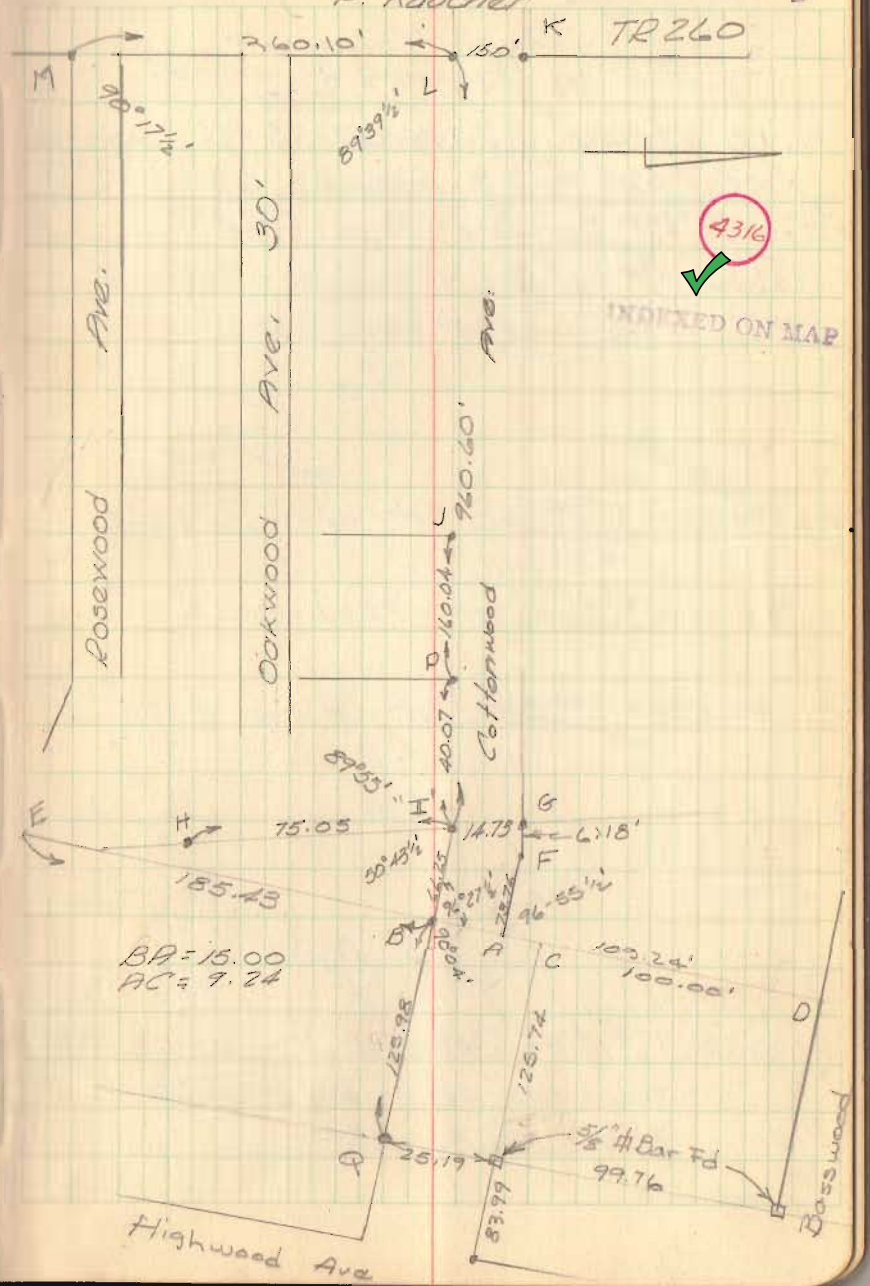

4316

INDEXED ON MAP