Lot # 171

Wise Allot. of Island View

Stokes Twp.

Victor F. Geise etal

5016 Airway Rd.

Dayton 3, Ohio

A = Found evidence of old hub - Set ½" Pipe

B = ½" Pipe set

C = ½" Pipe found - OK

D = Hub with tack found - set by F.F.W.

E = Rotten hub found - F.F.W. Replaced with ½" Pipe

F = [shaped Iron found - F.F.W.

G = ½" Iron pin set

H = Found evidence of old hub - Replaced with 1" Pipe

Note —

See F.F. Wright's F.B. "FW-15 pg. 69 & 153

INDEXED ON MAP
9607

D. E. Dodson
C. Nicholls

Aug 4, 1953
Hot - rain
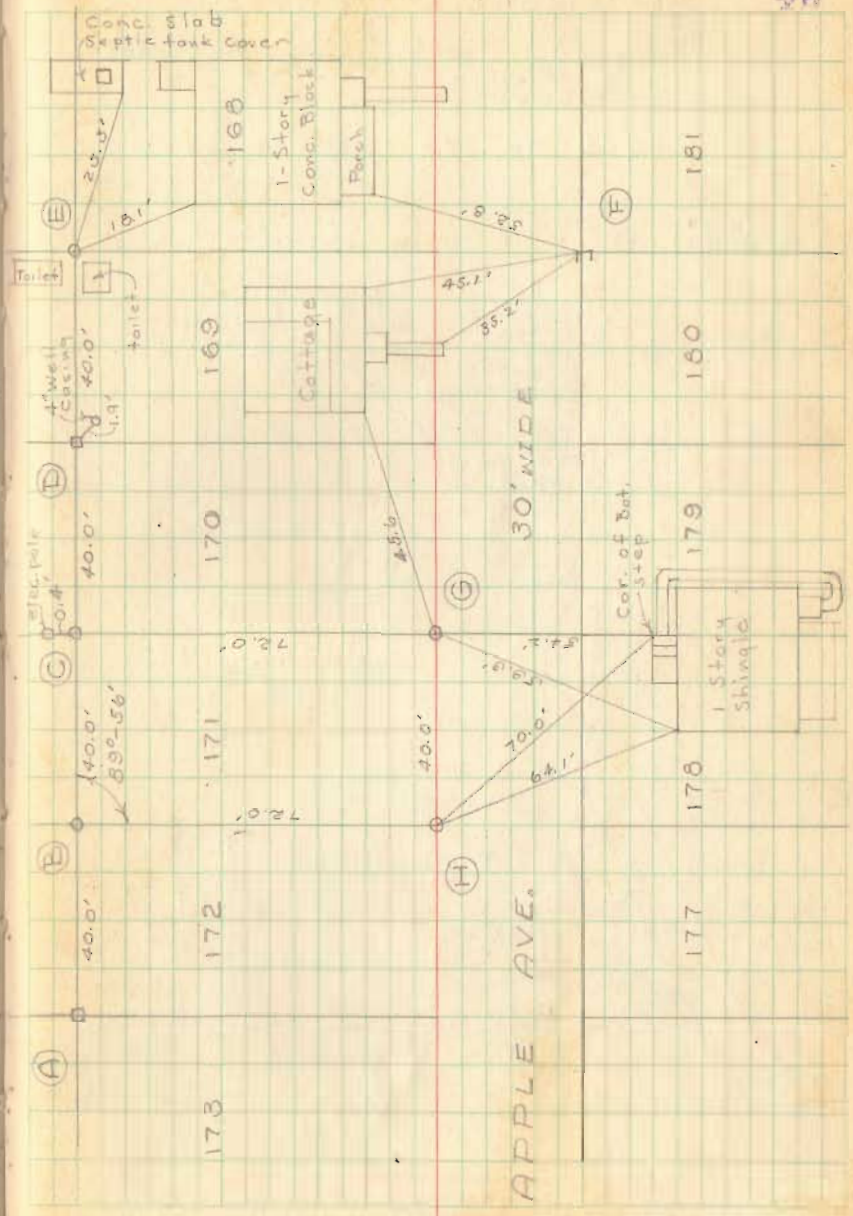
42