E.K. Bridge

Wortman farm survey

Union Twp. T4 R13 sec 22

A Iron Bolt Placed
B Old Cor. Post
C Old Cor. Post
D Old Cor. Post
E Old Cor. Post

4-18-31

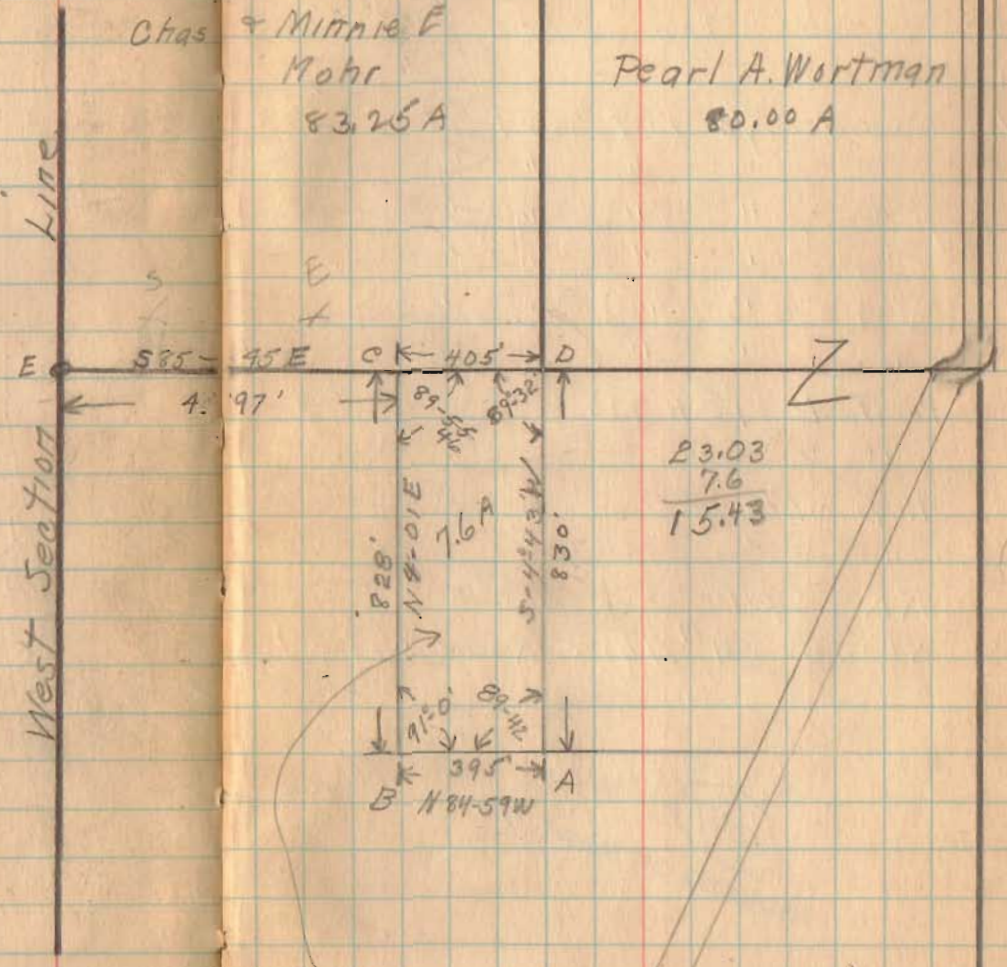

Sold to.
Lloyd H. Harner

1235

INDEXED ON MAP