Byler Survey – Union Twp.
Sec. 12 T. 4 R. 13

A. Stone found.
B. Iron Placed. } On line A to D
C. Iron Placed }
D Stone found. Plaed Brick on top.

1417
INDEXED ON MAP

1½' west of Fence cor.
stone found.
S. W. cor of
S.E. Quarter of
sec. 12 T. 4 R. 13

4 Road
No 30

A.S. King
119.68

Aug-13 -193-
Clear
Wright
J.E. Ellis
Patrick.
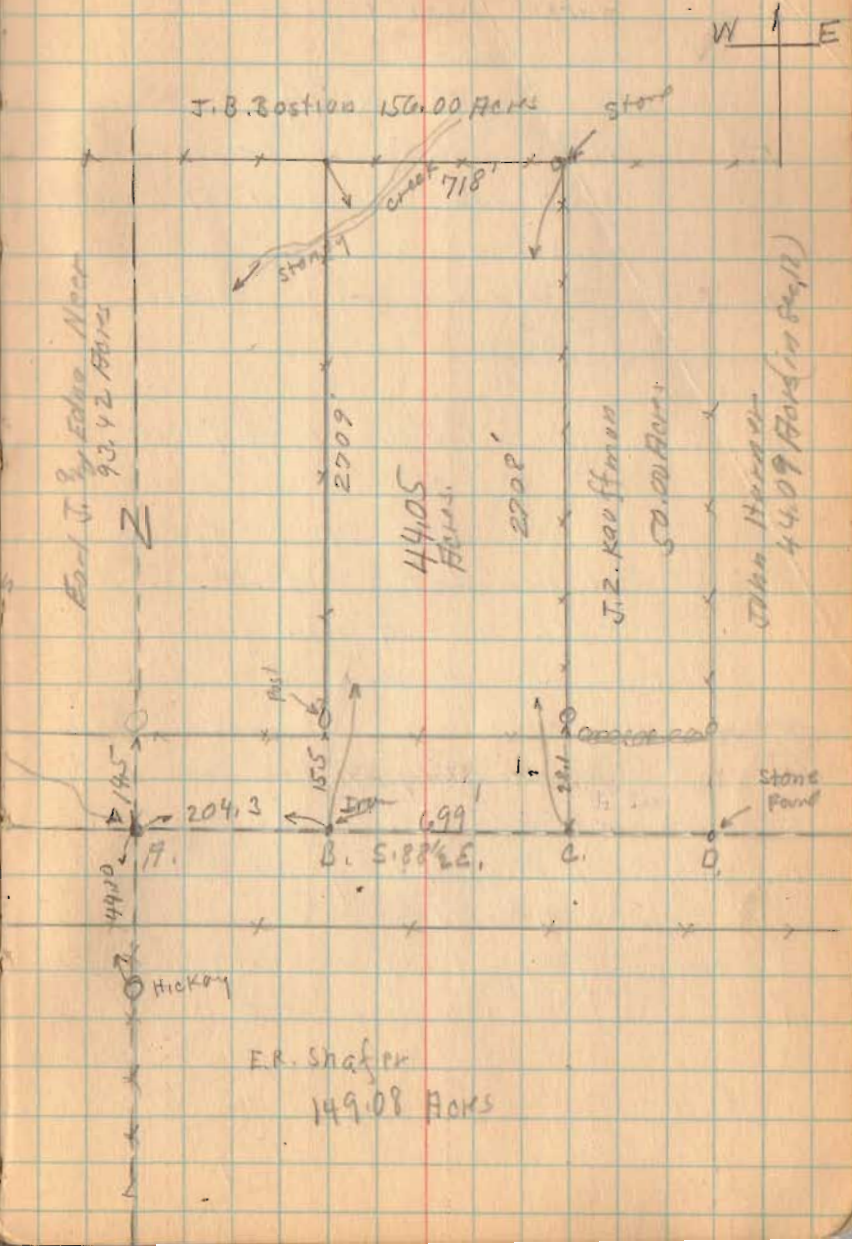
67