

Road 186

Union, Twp.

Section 1 Town 3 Range 14

30' Road, Road Record

No. 1 Page 283-307-312

Stated for 40' Road.

L. Moor

x x 17.57 x

Chas H. Buller

A. Michall

90° 30'

Road 187

1770


INDEXED ON MAP

stone
Cold,
F. Wright
G. Wilgus
G. Pusey

Road 186

Length 2731 Feet
 Length Miles
 Length Miles

2-1-37

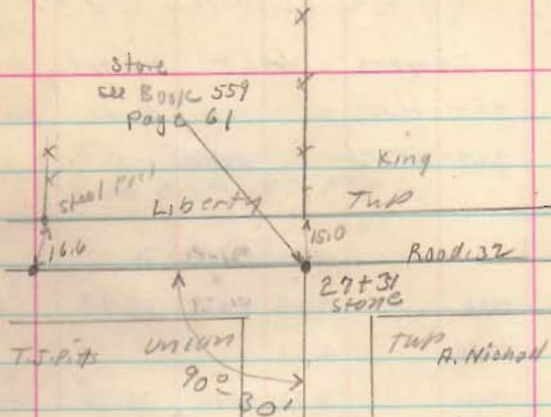

T.S.P.#s

12+19

A. Mohr

1970

INDEXED ON MAP