HENRY W. NEFF SURVEY ON ORCHARD ISLAND

The points B, C, D, E were established as shown by turning angles and measuring. The print of Orchard Island does not give any radii for their curves. Scaled distances were used.

A Old Hub found.
B Small iron found.
C Hub by Wright.
D Iron pipe by Wright
E Hub by Wright.
G Small iron found
H Old Hub found.
K Small Iron found
L Hub by Wright.
M " " "
N " " "
O " " "
P " " "
R Old Hub found replaced by new hub
S " " " " " "

Other irons found as shown

Tracing in Box 180

107

INDEXED ON MAP
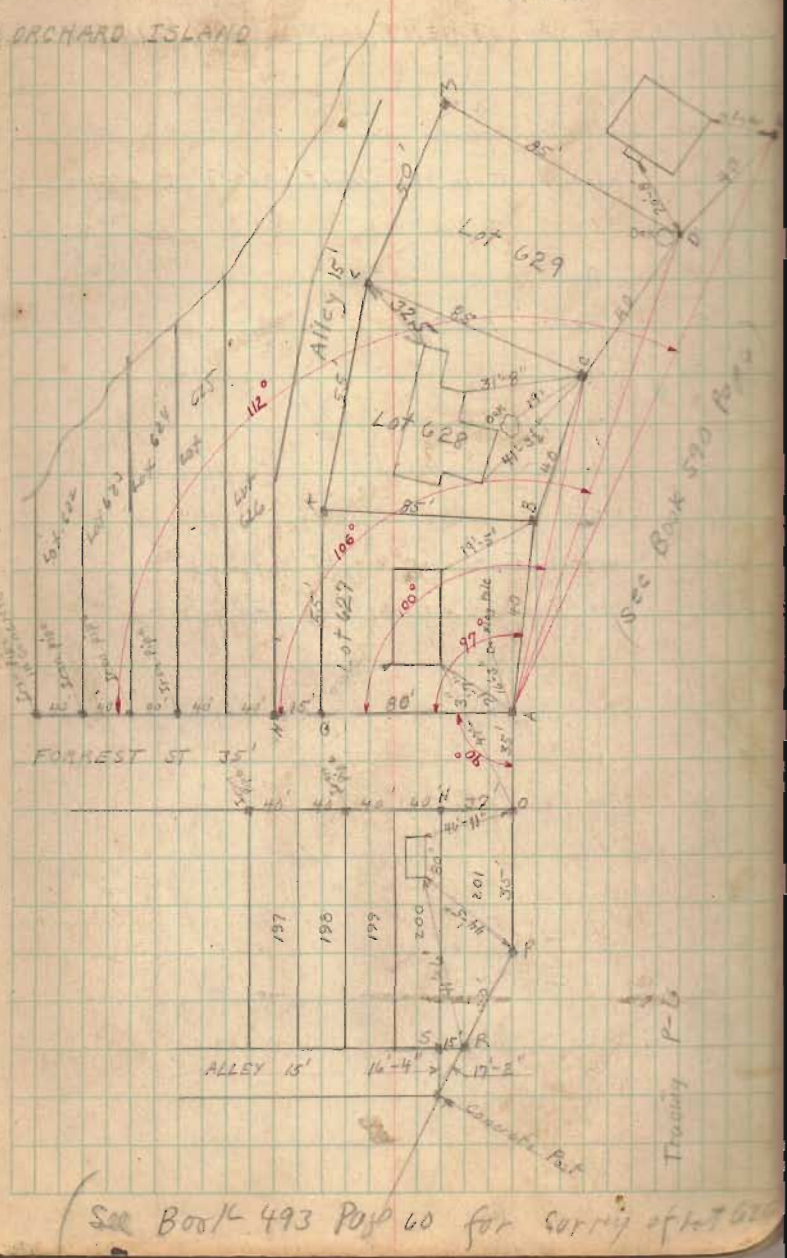
F. Wright
Ed. Corp.
Mr. Neff.