HILL CREST ALLOTMENT AT RUSSEL POINT

A	Old Iron found
B	Harrow Tooth by Wright (39'-8½° S. of Track ℄)
C	" " " "
D	Hub " "
E	Fence Post
F	Old Iron found
G	Gas pipe found
H	Old Iron found
K	" " "
L	Harrow Tooth by Wright
M	Old Iron found (12" under Surface)

Sec Book 385 Page 4

BC = 20'

LK = 20'

Section stone found and witnessed by Inskip, it was not used by Wright.

Sec. 36 T6 R8

Sec 1 T7 R8

Campbell To Smith Vol. 128 Page 421

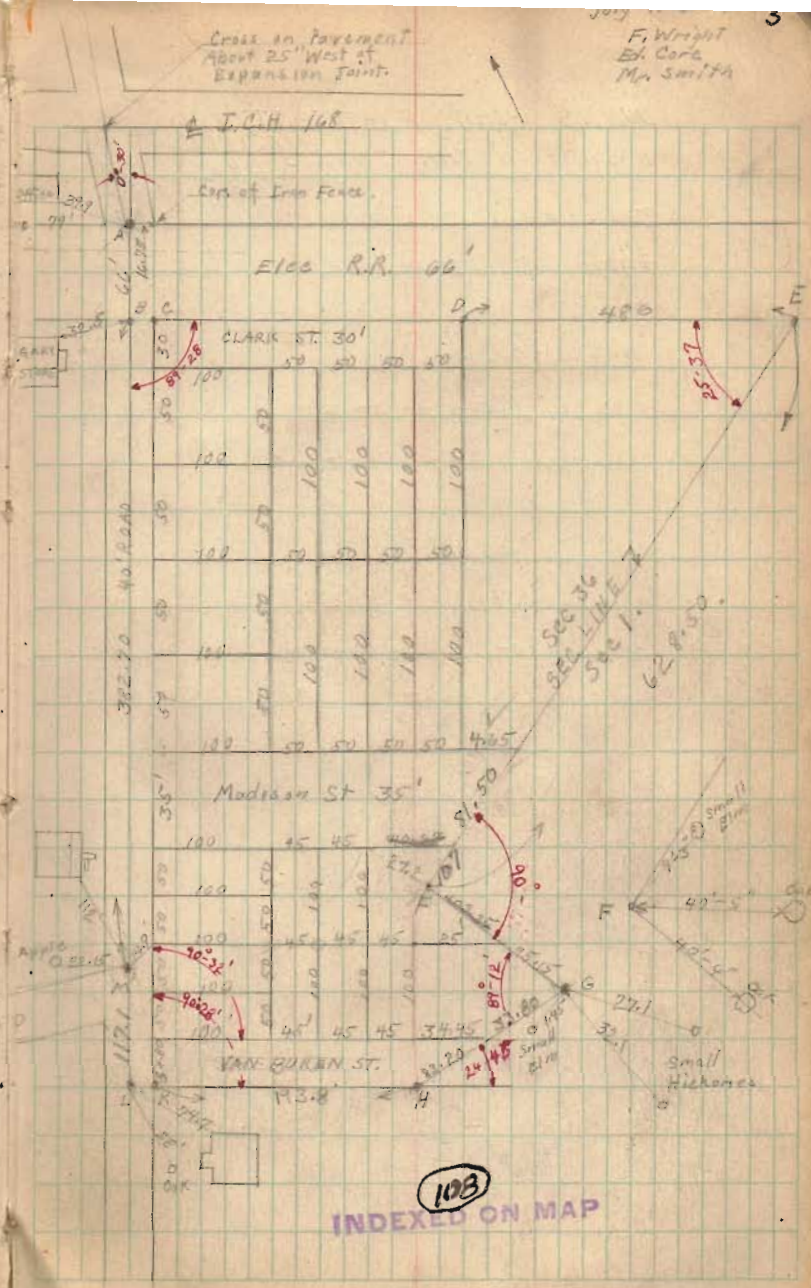

108

INDEXED ON MAP