Peter Mulitor at

Angle at NE Cor 73.65

1079

INDEXED ON MAP

Cottonwood

1st 50 = 75 [illegible]

2nd 52.25 = 81 [illegible]

3rd 52.25 = 84 4 links

4 - 85.50 1ch 30.25 links
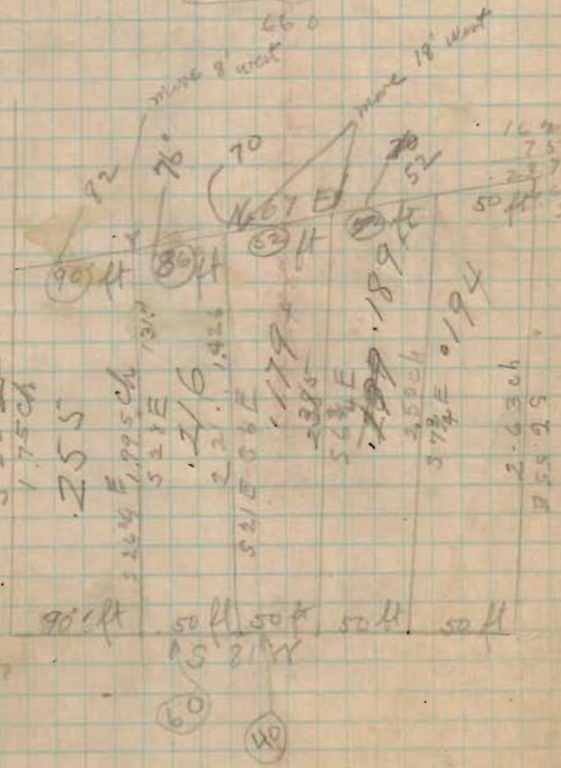
5 - 90 1ch 35 links