Mt Tabor Church
Washington Twp.
Sec. 11, T-2, R-14

FB 699

Survey to establish South line of Church property

Deed Vol. 45 pg. 110 Rec. Sept. 3, 1867
" " 216 " 87 " Sept 4, 1953

C. H. # 24 - 50' wide

Sept. 16, 1953
D. L. Dodson
T. L. Richardson
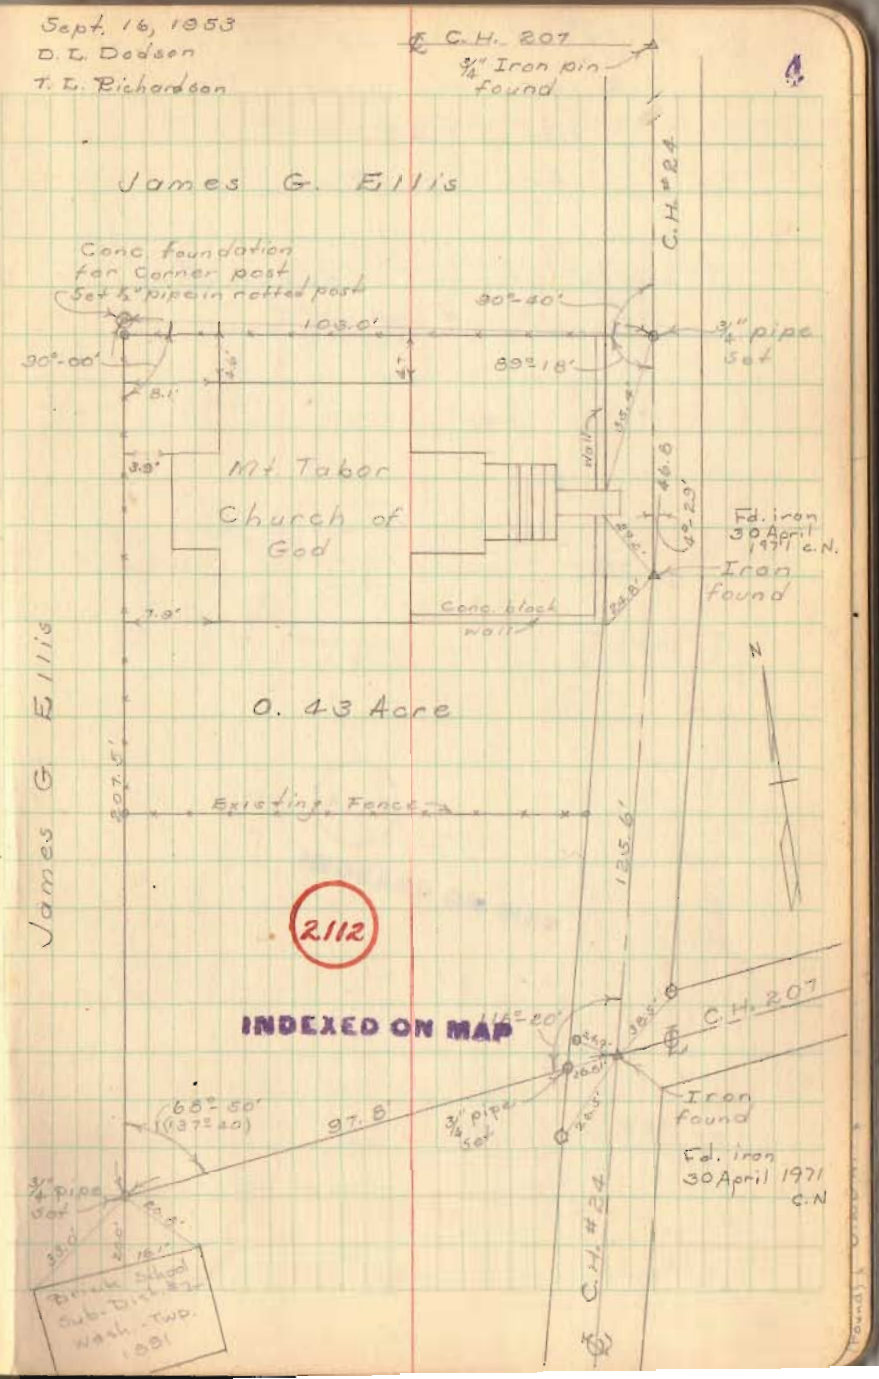
4