Survey Lot
Orchard Island
for O.W. Miller

A Iron pipe (found) 395' from marker at N corner Lot 578 accepted for NW cor 587

B Square stone (found) correct distance from NE corner Lot 578 accepted for W cor 590

C Intersection of E.E. with line 70' from BH. (pipe (set)

D pipe (set) on ℄ 15' vacated alley 7½' from C at Rt ∠'s to ℄ alley

E C.L. marker (found) SE. corner To Lot 588

F Iron bar (found) accepted for S corner Lot 590

G Iron bar (found) accepted for W corner Lot 563

9-5-46
CA Metcalf
CA Miller
Don Ferry

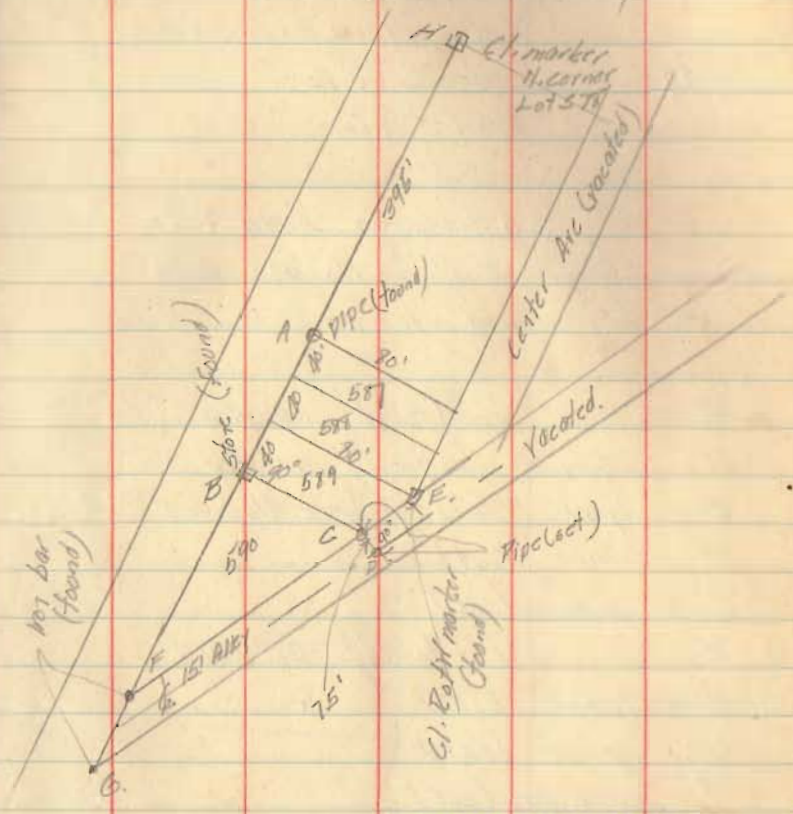

INDEXED ON MAP
2309