12-3-71

Five Points Addition, Washington Twp.

FB 701

All streets - 30'

A = R.R. Spike Found

B = Iron fence post with brick found - Replaced with 1" ø pipe

C = R.R. Spike found

D = R.R. Spike found

E = R.R. Spike found

F = Hub Found

G = Iron Pipe Found

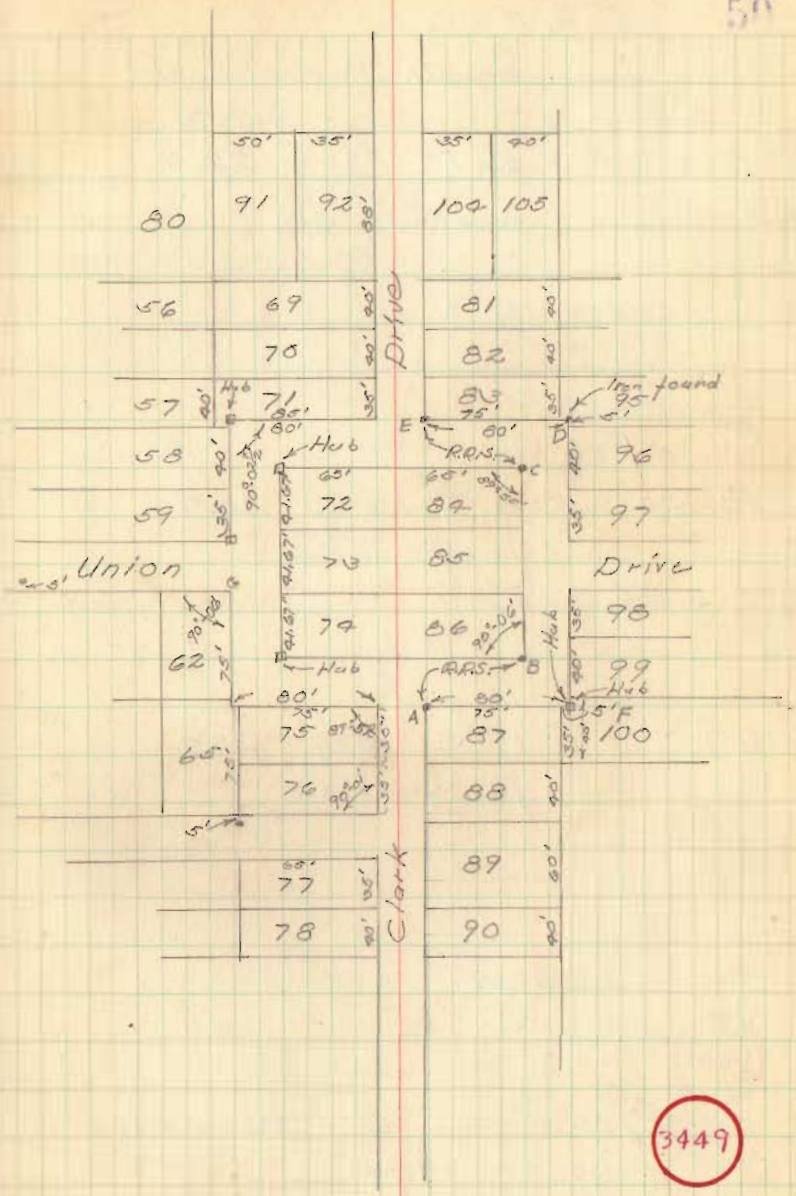

3449

INDEXED ON MAP