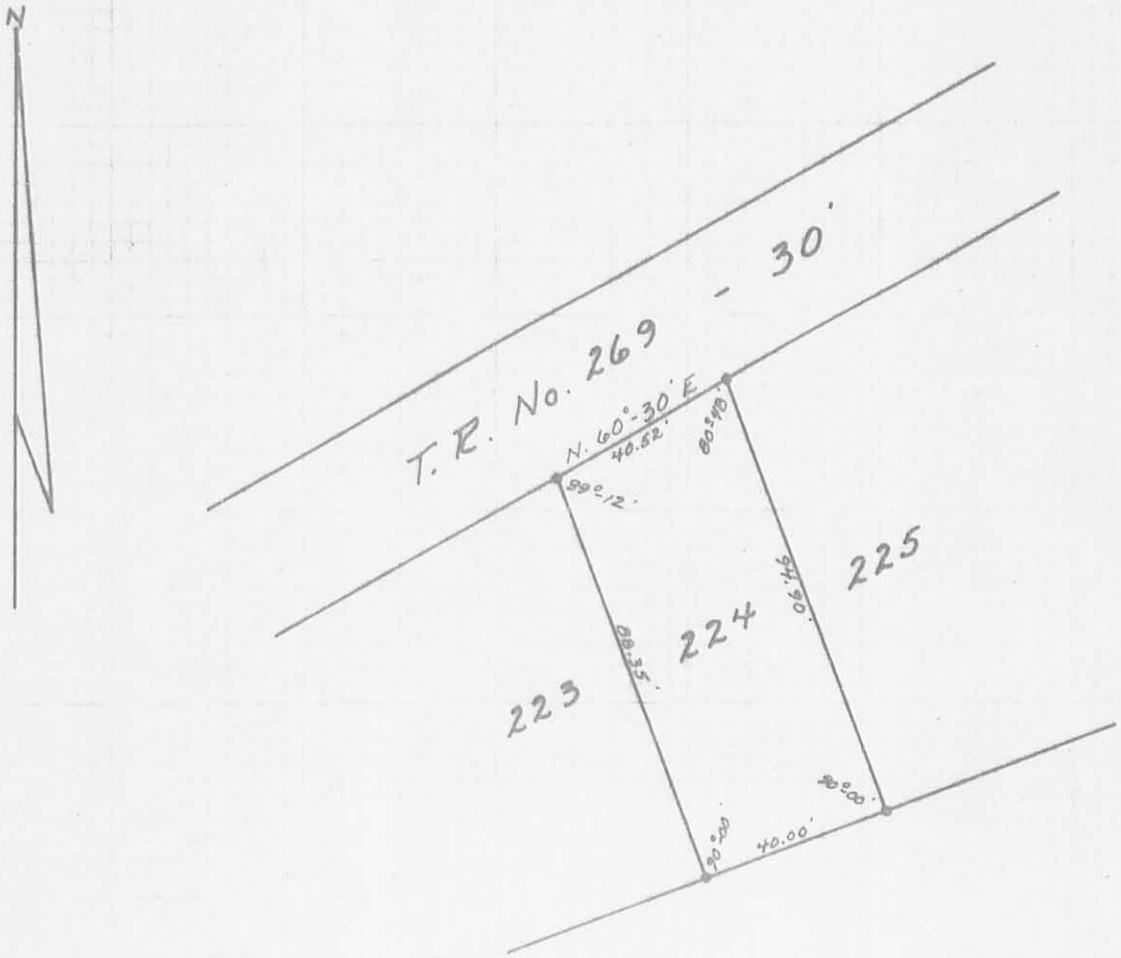

● - 5/8" ⌀ Iron Bars Set.

References:
Waterbury Summer Resort,
Plat Book C. Vol. 3 Pg. 1 & 2.
T. R. No. 269 (X-269).
Field Book 652.

INDEXED ON MAP
4876 IP

Surveyed and Platted By:
Daniel E. Gilbert, P.S.
Reg. Sur. No. 5402
428 N. Madriver St.
Bellefontaine, Ohio 43311

Survey of Lot 224
Waterbury Summer Resort
V.M.S. No. 9925-9946-10121
Washington Township
Logan County, Ohio
May 29, 1971

Scale: 1" = 40'