

Plat #2, Yoder Add'n.

501 502 503 504 505 506 507 508 509 510 511 512 513 514 515 516

Pickrelltown Road

Plat of the Joshua Lance Tract of 3.75 Acres.

Located in West Liberty, Ohio.

Measurements shown in feet, tenths & hundredths of feet.

August, 1920.

Summitt P. Sweetman, Civil Engineer, Urbana, Ohio.

Approved by the Village Council of West Liberty, Ohio.

August 12, 1920

John C. Rock, Mayor.

Ralph M. Craig

Transferred August 14, 1920. N.W. Corbet, Auditor, S. L. S.

\$100.00

Presented for Record Aug 14 1920 at 939

Recorded Aug 16 1920 Plat Book A

County Recorder

1447 INDEXED ON MAP




Newell Street 60 feet.

Book FW-27  
Page 65



RICKERTOWN ROAD

W. E.

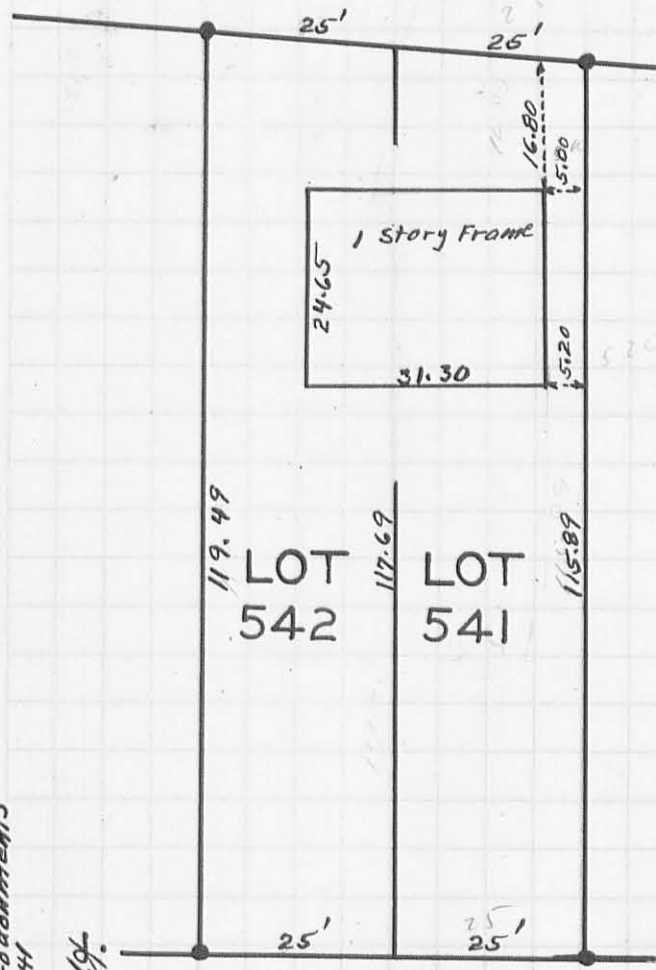

*I find no encroachments  
on lots 542 and 541  
August 8, 1953  
Foster F. Wright*

ELMORE SURVEY

LOTS 542 & 541  
LANE ALLOTMENT

WEST LIBERTY OHIO  
AUGUST 1953 1" = 25'  
FOSTER F. WRIGHT

● IRONS

INDEXED ON MAP  
1447 2P