

*Dybert copy*

Levi O. Woodruff to the Liberty Machine Products-

A parcel of land in the village of West Liberty, Logan County, Ohio, and being part of Lots No. 2 and 3 in said village, described as follows:

Beginning at a point on the north line of said Lot No. 3, 150 feet easterly from the northwest corner of said Lot-

Thence southerly, parallel with the westerly line of said Lot No. 3, a distance of 50 feet to a point-

Thence easterly, parallel with the northerly line of said Lot No. 3, a distance of 32 feet to a point-

Thence southerly, parallel with the westerly line of said Lot No. 3 and 2, a distance of 12 feet to a point-

Thence easterly, parallel with the northerly line of said Lot No. 3 and 2, a distance of 28 feet to a point-

Thence northerly, parallel with the westerly line of said Lot No. 2 and 3, a distance of 62 feet to a point on the northerly line of said Lot No. 3-

Thence westerly, along the northerly line of said Lot No. 3, a distance of 60 feet to the point of beginning.

Reserving to the Dayton Power and Light Co. and its successors joint use with the grantee herein of a roadway centering along and upon the easterly line of this described parcel.

\*\*\*\*\*

Said parcel being a part of Tract No.2 as conveyed to Levi O. Woodruff by Nellie M. and Judd W. Wilkins in the document recorded in deed volume 170, page 268, of the County Recorder's Office of Logan County.

*Cem*  
Cecil E. Mengerink  
Registered Surveyor #3151.

*2/26/59*

*on Plat Book*

2490 1D-1

to the Liberty Machine Products-

A parcel of land in the village of West Liberty, Logan County, Ohio, and being part of Lot No. 2 in said village, described as follows:

Beginning at a point on the north line of said Lot No. 2, 150 feet easterly from the northwest corner of said Lot-

Thence southerly, parallel with the westerly line of said Lot No. 2, a distance of 12 feet to a point-

Thence easterly, parallel with the northerly line of said Lot No. 2, a distance of 32 feet to a point-

Thence northerly, parallel with the westerly line of said Lot No. 2, a distance of 12 feet to a point on the northerly line of said Lot No. 2-

Thence westerly, along the northerly line of said Lot No. 2, a distance of 32 feet to the point of beginning.

\*\*\*\*\*

It is my opinion that Geraldine C. Keely received this parcel from Roy L. Keely by document recorded in deed volume 177, page 545, of the County Recorder's Office of Logan County.


I suggest that Levi O. Woodruff quit claim any interest he might have in this parcel also.

INDEXED ON MAP  
2490 1D 2

*CKM*  
Cecil E. Mengerink  
Registered Surveyor #3151.

3/2/59

SURVEY OF  
PART OF LOTS NO. 2 AND 3 IN THE VILLAGE OF WEST  
LIBERTY, LOGAN COUNTY, OHIO.

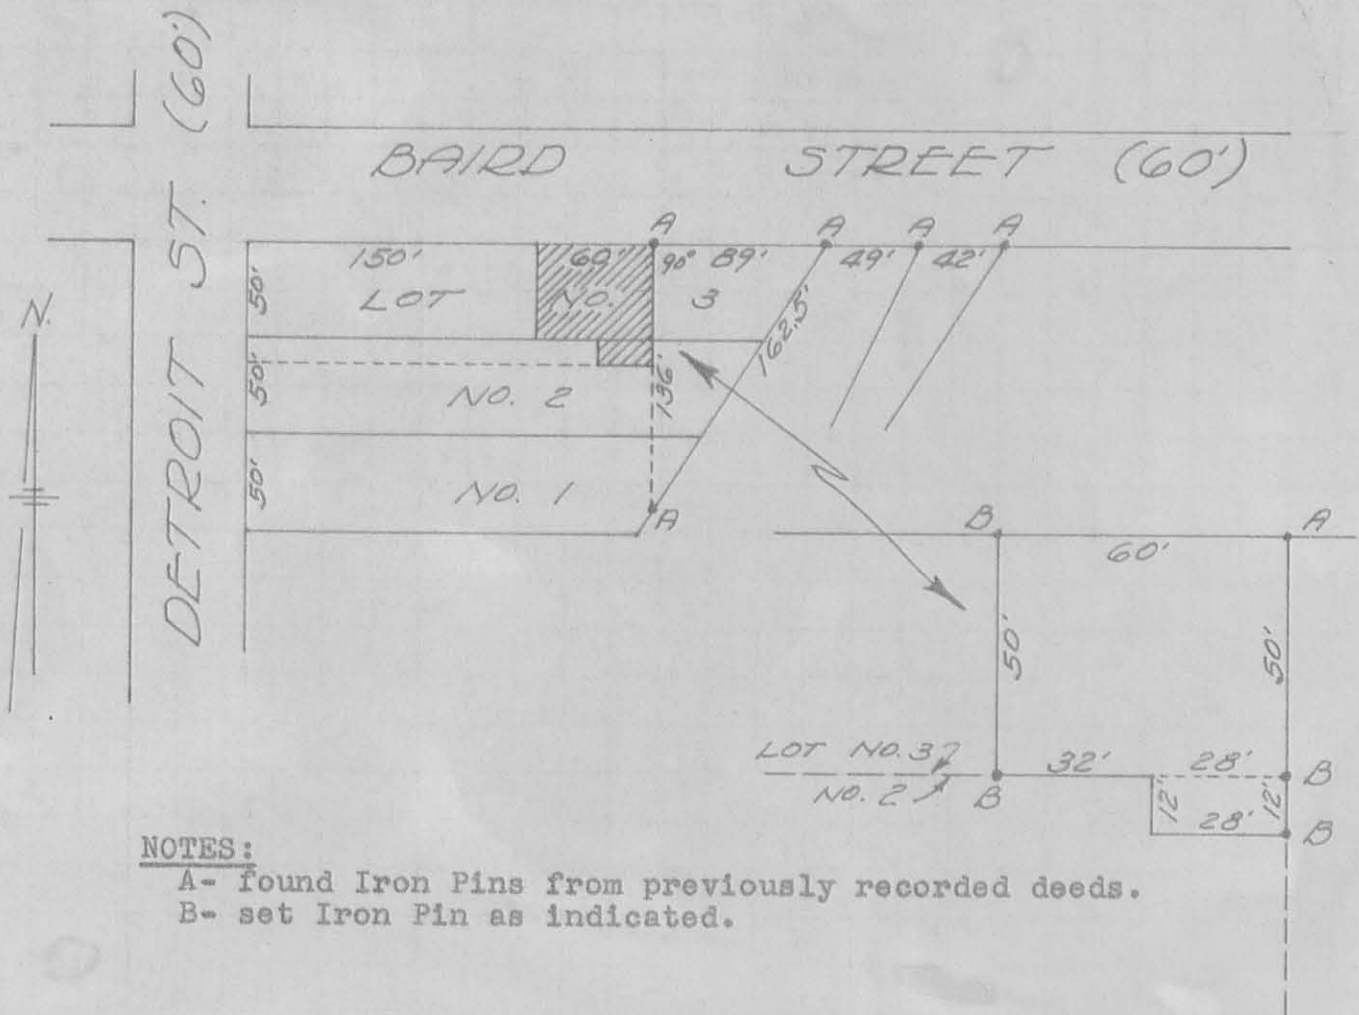

**NOTES:**

- A- found Iron Pins from previously recorded deeds.
- B- set Iron Pin as indicated.

I hereby certify the above Plat and Survey to be correct.  
Surveyed February 25, 1959.

2490 IP

*Cecil E. Mengerink*  
Cecil E. Mengerink  
Registered Surveyor #3151.