

1. D. B. ...
 2. J. ...
 3. ...
 4. ...
 5. ...
 6. ...
 7. ...
 8. ...

LOGAN COUNTY
 PERRY TOWNSHIP

UNION COUNTY
 LIBERTY TOWNSHIP


ST. MARYS BRANCH -- MAIN LINE
 FROM STATION 201+29.5 TO STATION 305+1.0

SCALE 1 INCH = 200 FEET

OFFICE OF VALUATION ENGINEER, COLUMBUS, OHIO

RIGHT OF WAY AND TRACK MAP
 THE TOLEDO AND OHIO CENTRAL RAILWAY
 OPERATED BY
 THE TOLEDO AND OHIO CENTRAL RAILWAY COMPANY

JUNE 30, 1918

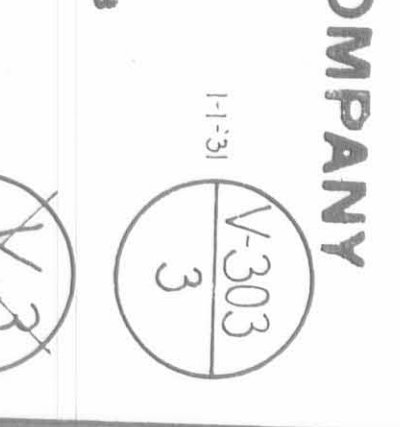

3036
 10
 1
 2
 3
 4
 5

SCHEMATIC OF PROJECT
 DATE
 RECORD
 CHECKED
 REMARKS

LOGAN COUNTY
 PERRY TOWNSHIP
 JEFFERSON TOWNSHIP


ST. MARYS BRANCH -- MAIN LINE
 FROM STATION 400+00 TO STATION 500+00
 SCALE 1 INCH = 200 FEET
 JUNE 30, 1918

RIGHT OF WAY AND TRACK MAP
 THE TOLEDO AND OHIO CENTRAL RAILWAY
 OPERATED BY
 THE TOLEDO AND OHIO CENTRAL RAILWAY COMPANY

ST. MARYS BRANCH -- MAIN LINE
 FROM STATION 400+00 TO STATION 500+00
 SCALE 1 INCH = 200 FEET
 JUNE 30, 1918

OFFICE OF VALUATION ENGINEER, CALUMBA, OHIO.
 OPERATED BY THE NEW YORK CENTRAL RAILROAD
 COMPANY SUBSEQUENT TO DECEMBER 31, 1921

R-36
 V-303
 5

 

This plan is for record; information not to be complete or correct, and not to be used for anything but the purpose for which it was prepared. The engineer assumes no responsibility for any errors or omissions.


303-9
 10 Joseph Shoofs
 T & O C Ry Co
 No. 1 - Conveyed to J & I N Ry Co. by J. T. Adams by G. D. Deed, Feb 18, 1899
 Recorded Vol. 95, Page 1301, Dist. No. 1317











 

RIGHT OF WAY AND TRACK MAP
 THE TOLEDO AND OHIO CENTRAL RAILWAY
 OPERATED BY
 THE TOLEDO AND OHIO CENTRAL RAILWAY COMPANY


ST. MARYS BRANCH -- MAIN LINE
 FROM STATION 700+00 TO STATION 800+00
 SCALE 1 INCH = 200 FEET
 OFFICE OF VALUATION ENGINEERS, COLUMBUS, OHIO.
 JUNE 30, 1918

REVISIONS


Notes:
 All Property on this Map
 relied from operation 12-15-37

SUMMIT
OHIO.

 

303.10

No.	Inspector	Station	Date	Remarks

RIGHT OF WAY AND TRACK MAP
 THE TOLEDO AND OHIO CENTRAL RAILWAY
 OPERATED BY
 THE TOLEDO AND OHIO CENTRAL RAILWAY COMPANY

ST. MARYS BRANCH -- MAIN LINE
 FROM STATION 800+00 TO STATION 899+82.
 SCALE 1 INCH = 200 FEET
 JUNE 30, 1918

LOGAN COUNTY
 JEFFERSON TOWNSHIP
 LAKE TOWNSHIP

James E. Funk.

Note: All Property on this Map East of Sta. 881+00 retired from operation 12-15-37

Match Mark

Match Mark

303.10

NO. 1 - Corrected to D. S. T. R. Co. by J. W. May, Apr. 27, 1901, Note No. 1

NO. 2 - Corrected to D. S. T. R. Co. by J. W. May, Apr. 27, 1901, Note No. 1

SUMMIT
OHIO.

 

Note: -
All Property on this Map East of
Sta. 891+00 relieved from operation 12-15-37

RIGHT OF WAY AND TRACK MAP
THE TOLEDO AND OHIO CENTRAL RAILWAY
OPERATED BY
THE TOLEDO AND OHIO CENTRAL RAILWAY COMPANY



LOGAN COUNTY
JEFFERSON TOWNSHIP
LAKE TOWNSHIP

SHEET NO. 10 OF 24 OF THE TOLEDO AND OHIO CENTRAL RAILWAY
FROM STATION 800+00 TO STATION 899+82
VALUATION ENGINEER

ST. MARY'S BRANCH -- MAIN LINE
FROM STATION 800+00 TO STATION 899+82
SCALE 1 INCH = 200 FEET
OFFICE OF VALUATION ENGINEER, COLUMBUS, OHIO
JUNE 30, 1918

V-303
9
R-36

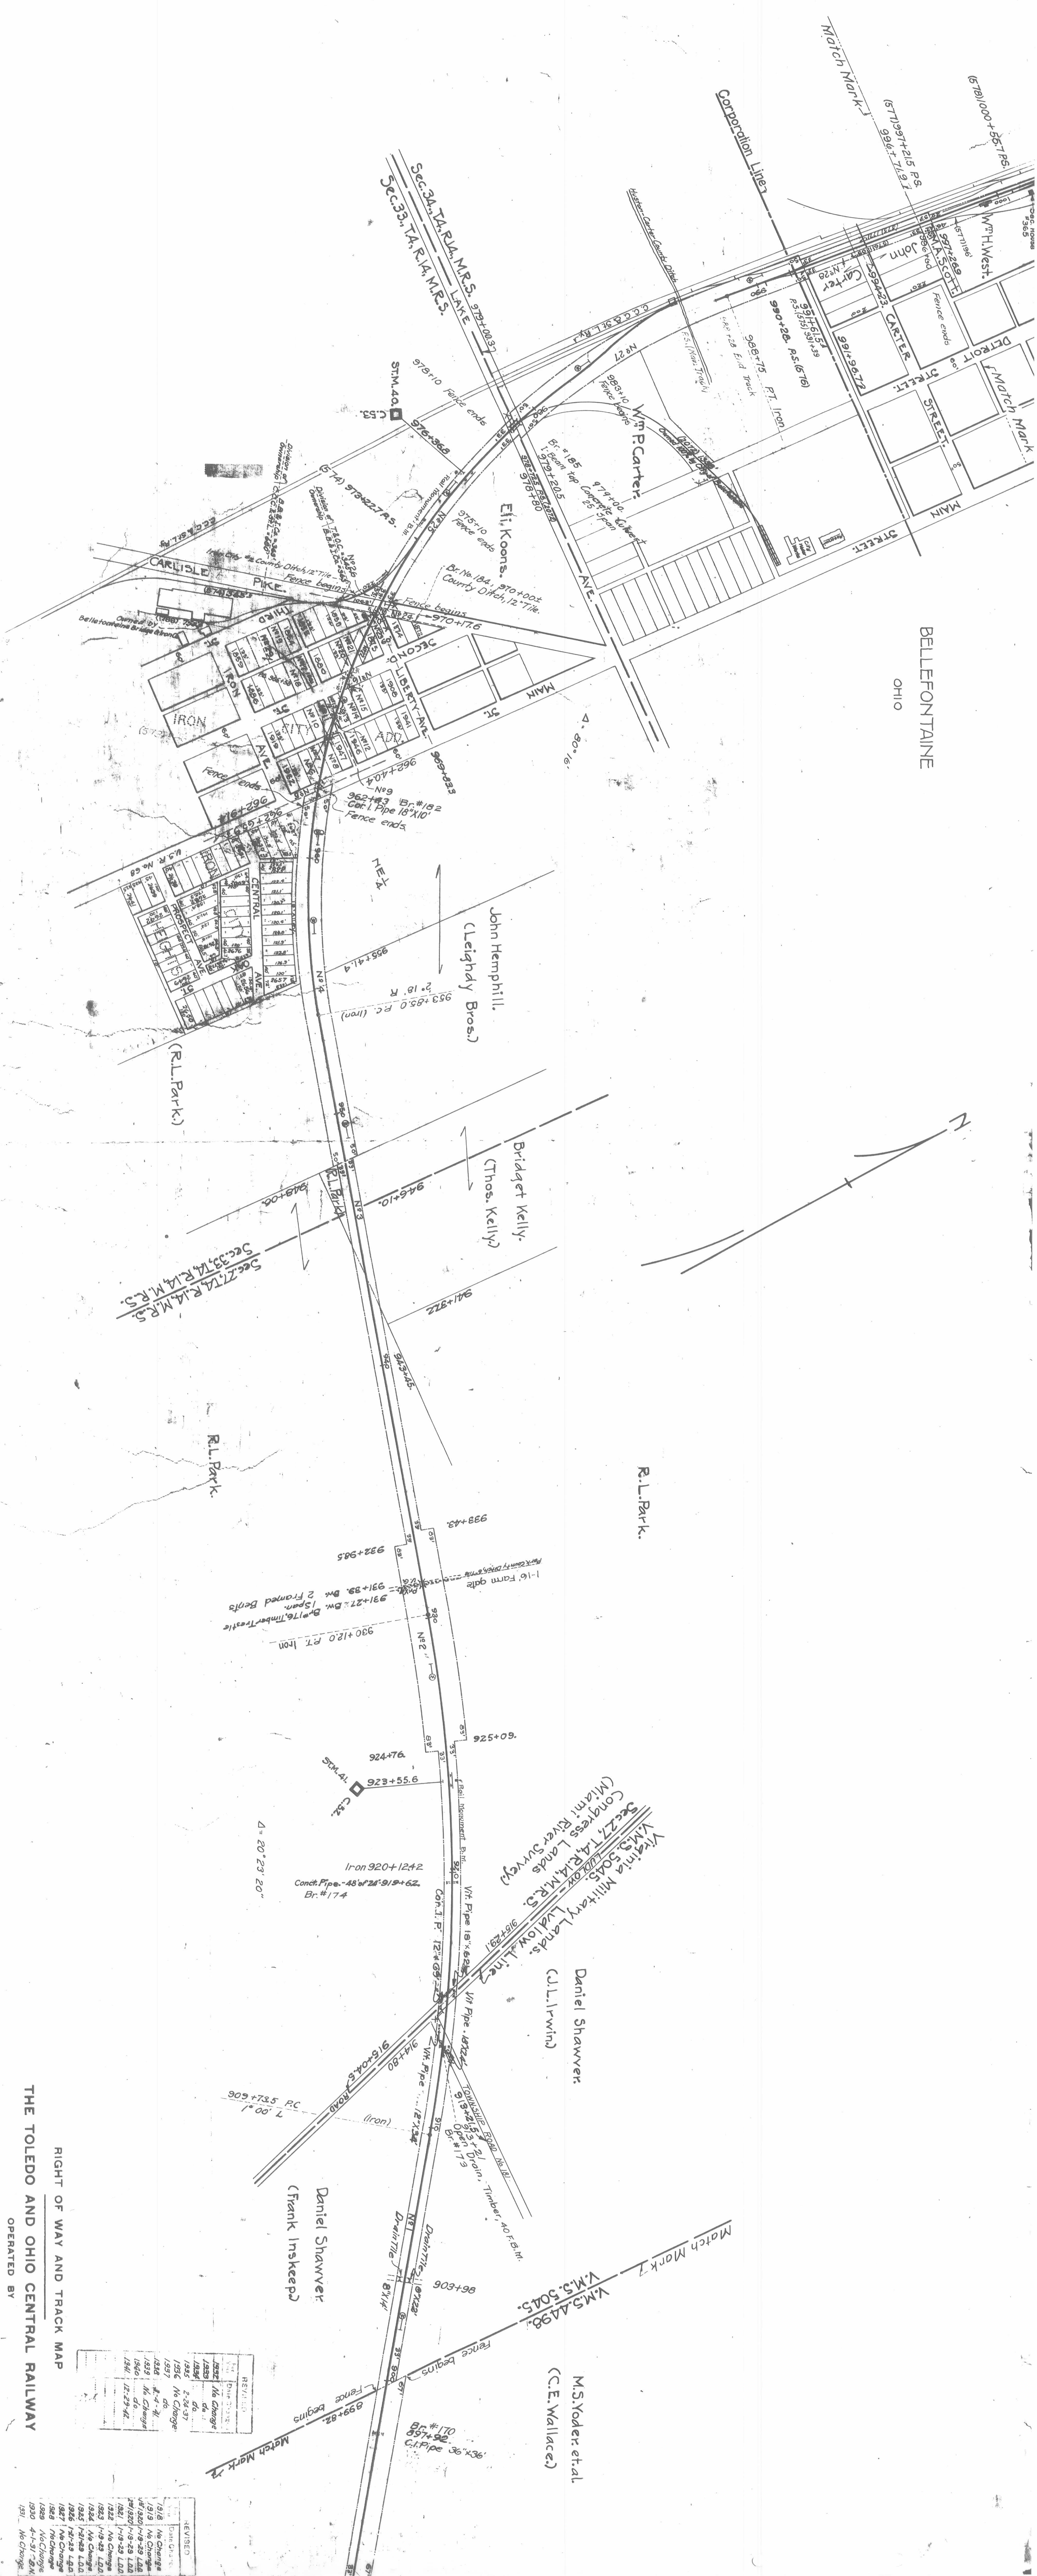

BELLEFONTAINE
OHIO

LOGAN COUNTY
LAKE TOWNSHIP


RIGHT OF WAY AND TRACK MAP
THE TOLEDO AND OHIO CENTRAL RAILWAY
OPERATED BY
THE TOLEDO AND OHIO CENTRAL RAILWAY COMPANY

ST. MARY'S BRANCH -- MAIN LINE
FROM STATION 899+02. TO STATION 996+71.9
SCALE 1 INCH = 200 FEET
JUNE 30, 1918

SHEET NO. 11 OF 34 OF THE TOLEDO AND OHIO CENTRAL RAILWAY
FROM SURVEY STATION 899+02 TO SURVEY STATION 996+71.9
J. C. ...
VALUATION ENGINEER

OFFICE OF VALUATION ENGINEER, COLUMBUS, OHIO
R-36

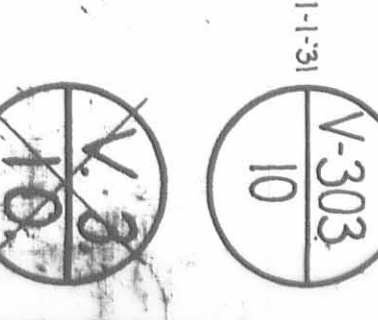

Match Mark



LOGAN COUNTY
LAKE TOWNSHIP

RIGHT OF WAY AND TRACK MAP
 THE TOLEDO AND OHIO CENTRAL RAILWAY
 OPERATED BY
 THE TOLEDO AND OHIO CENTRAL RAILWAY COMPANY

ST. MARYS BRANCH -- MAIN LINE
 FROM STATION 994+71.9 TO STATION 1050+00
 SCALE 1 INCH = 100 FEET
 OFFICE OF ENGINEERING AND CONSTRUCTION
 THE TOLEDO AND OHIO CENTRAL RAILWAY COMPANY
 CLEVELAND, OHIO
 1-1-31

NO.	DATE	REVISIONS
1232	1/16/20	No Change
1233	1/16/20	do
1234	1/16/20	do
1235	1/16/20	do
1236	1/16/20	do
1237	1/16/20	No Change
1238	1/16/20	do
1239	1/16/20	do
1240	1/16/20	No Change
1241	1/16/20	No Change


R-36

Br. #209
1103+51 C.I. Pipe 12"x30"

Hannah Robinson.

Elizabeth Pash.
(Sallie Pash.)

Edward Houz.

BELLEFONTAINE
OHIO

Match Mark 7 1099+49
Fence ends
Pr. # 1099+30. 1-16 Farm gate
Match Mark
Fence ends
Pr. # 1099+30. 1-16 Farm gate

1090+75
Pr. # 1090+75
1-16 Farm gate
1080+89
1080+78 Br. No. 206
32" of 12" Cor. I. Pipe

1081+92.6
Fall Monument B.M.
C.S.S.
1082+00.28
F.T.C. Iron
1079+76.22 R.C.C. Iron
O. 4.0' 10" L.

Br. #205
1079+58 Vit. Pipe 18"x48"
Vit. Pipe 12"x4"

Corporation Line 1074+46.7

1073+76.22 R.C.C. Iron 1.3' L. of E
1071' L.

Michael Cartmell
Δ=3°21'

1069+35.7
Fence begins

0° 34' L.
Iron 1067+26.14 R.C.C.

1066+12.1
Pr. # 1066+12.1
1065+09
Fence ends
Cement Block Co.

1062 L.
Iron 1061+75.8 R.C.C.

Br. #201
1060+52
Open Drain, timber
350 F.B.M.
1059+89 Fence begins
1058+15 (325)

HARRISON TOWNSHIP
TROY ST.
Sec. 5, 13, 14, R. 14, M. 13.
LAKE TOWNSHIP
Sec. 35, 14, R. 14, M. 13.

Year	Change
1922	No Change
1923	do
1924	do
1925	do
1926	do
1927	do
1928	do
1929	do
1930	do
1931	do
1932	do

RIGHT OF WAY AND TRACK MAP
THE TOLEDO AND OHIO CENTRAL RAILWAY
OPERATED BY
THE TOLEDO AND OHIO CENTRAL RAILWAY COMPANY

ST. MARYS BRANCH -- MAIN LINE
FROM STATION 1050+00 TO STATION 1099+49
JUNE 30, 1918

LOGAN COUNTY
LAKE TOWNSHIP
HARRISON TOWNSHIP

SHEET NO. 13 OF 34 OF THE TOLEDO AND OHIO CENTRAL RAILWAY
ST. MARYS BRANCH MAIN LINE
FROM STATION 1050+00 TO STATION 1099+49

VALUATION ENGINEER

SCALE 1 INCH = 100 FEET
OFFICE OF VALUATION ENGINEER, COLUMBUS, OHIO.

11-3
V-303
12

R-36
12

OPERATED BY THE NEW YORK CENTRAL RAILROAD COMPANY SUBSEQUENT TO DECEMBER 31, 1917.
JUNE 30, 1918