


Item	A.F.E.	Quantity	Unit	Amount

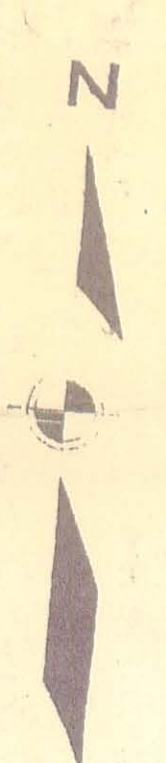

1951 No Change
 1952 " "
 1953 " "
 1954 " "
 1955 4.1-58
 1956 No Change
 1957 2.4-60
 1959 No Change


CONNECTED TO DECEMBER 31, 1955

Sheet No. ST.30a of 4
 From Survey Station 7385+20
 S. C. C. & S. L. Ry. Co.
 Station 7385+20
 Station 7438+00

STATION MAP—TRACKS AND STRUCTURES
 THE CLEVELAND, CINCINNATI, CHICAGO & ST. LOUIS RY. CO.
 INDIANAPOLIS DIVISION—MAIN LINE
 THE CLEVELAND, CINCINNATI, CHICAGO & ST. LOUIS RY.
 Operated by

Office of Valuation Engineers, Cincinnati, O.
 June 30th, 1915
 Scale 1 in. = 100 FT.



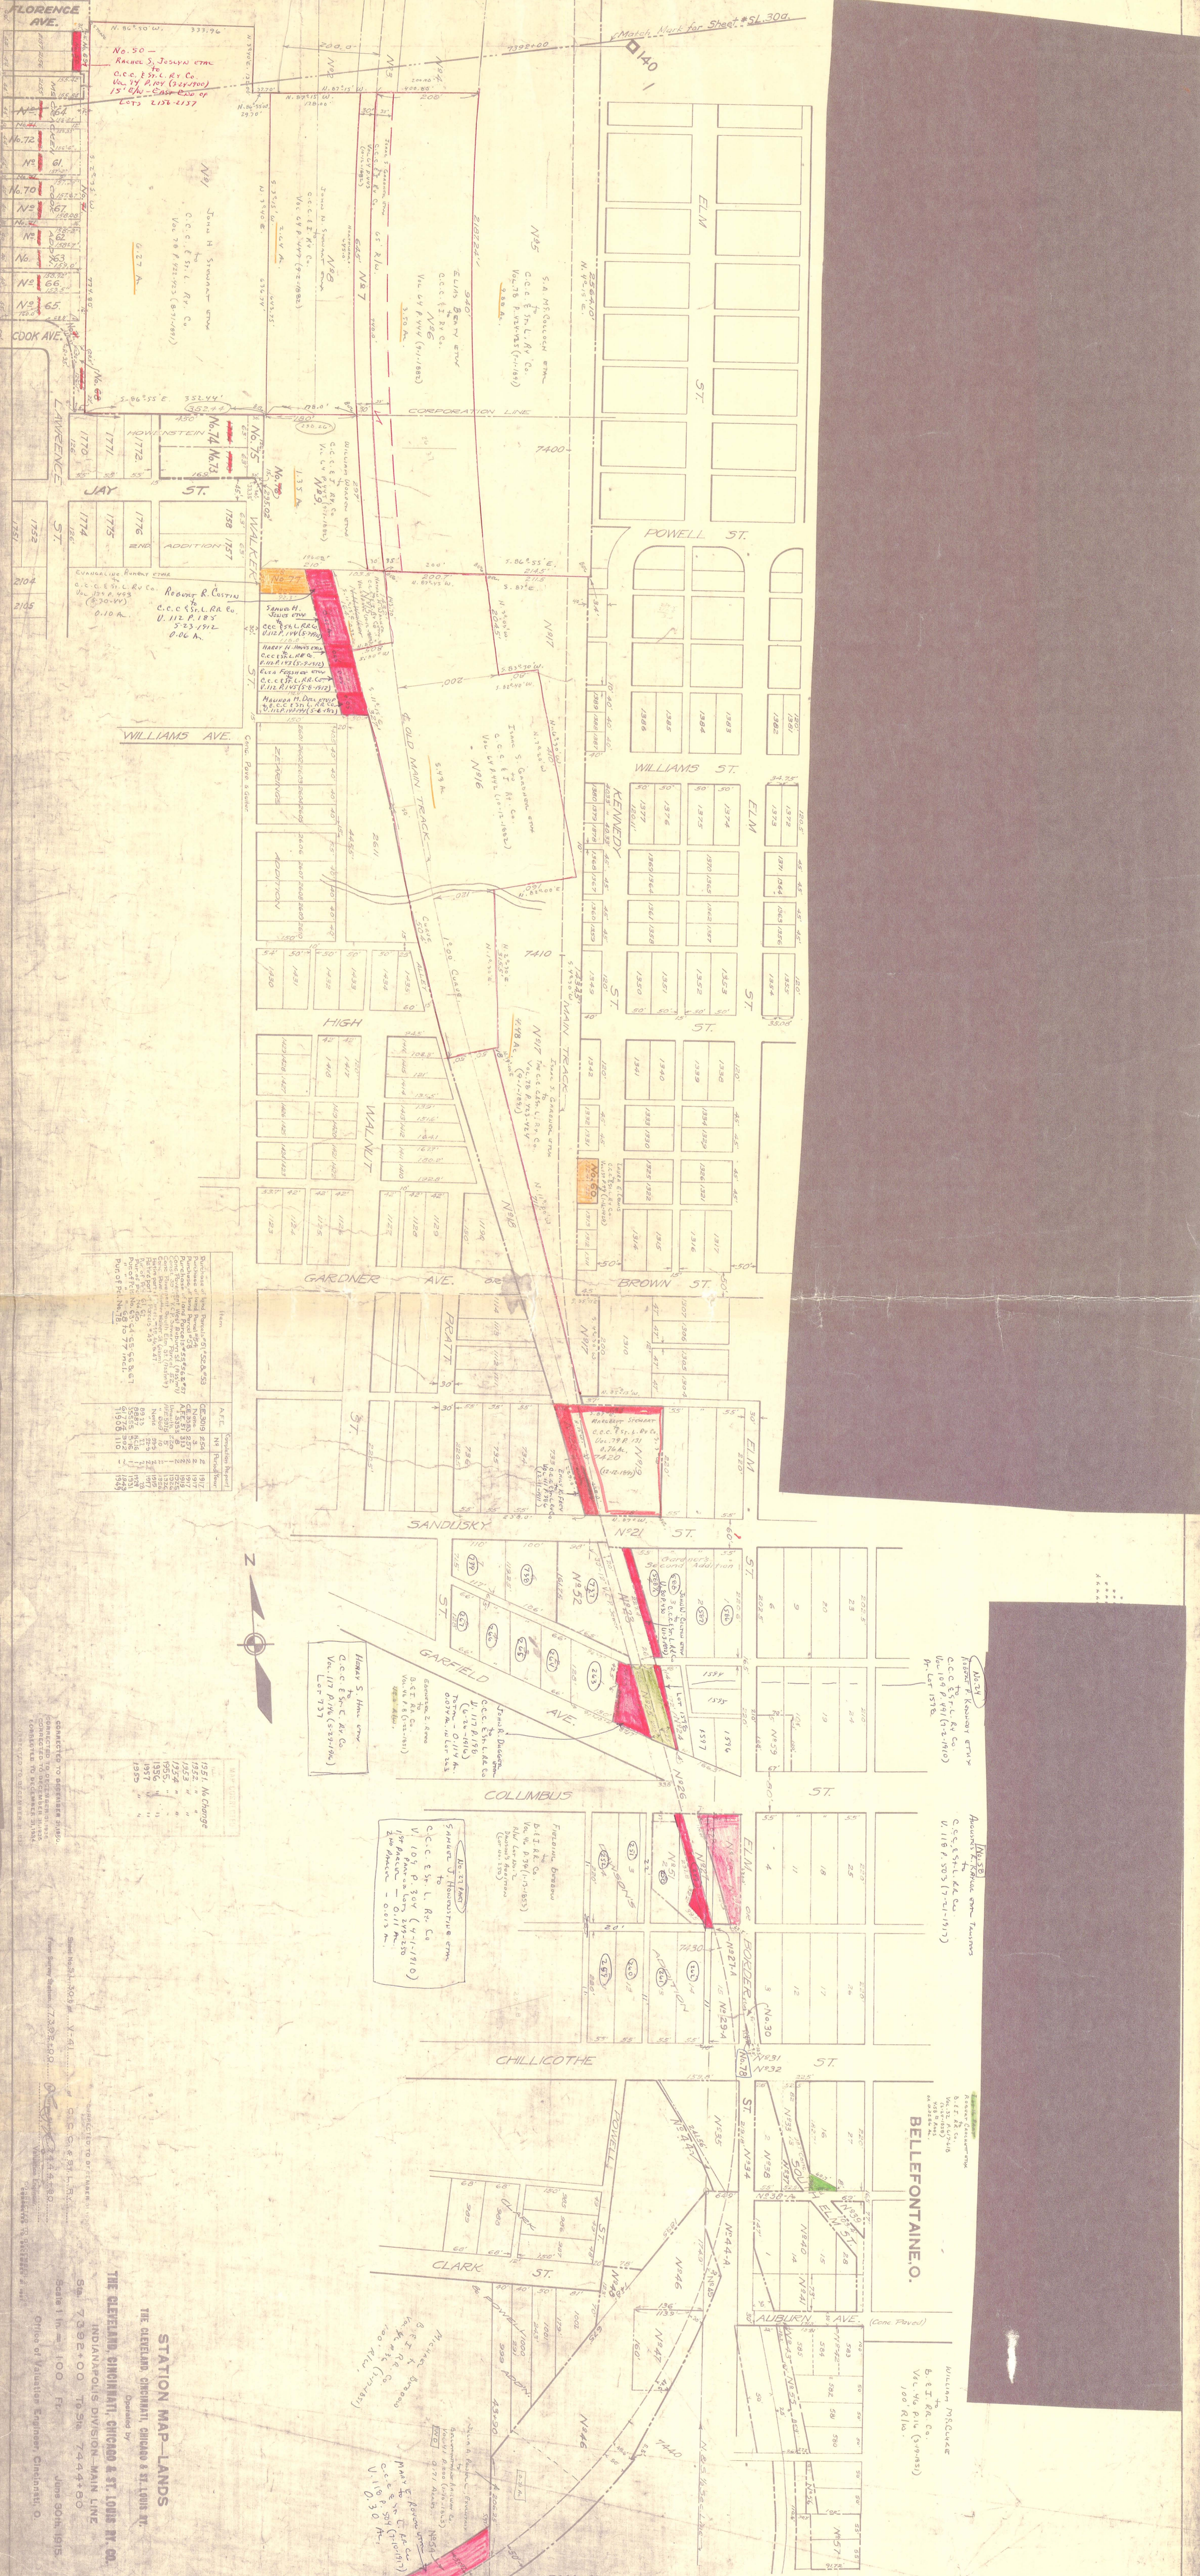

RECORDS

No.	Year	Volume	Page
No. 50	1917	157	157
No. 51	1917	157	157
STATION MAP-LANDS
 THE CLEVELAND, CINCINNATI, CHICAGO & ST. LOUIS R.R. CO.
 INDIANAPOLIS DIVISION MAIN LINE
 Prepared by
 THE CLEVELAND, CINCINNATI, CHICAGO & ST. LOUIS R.R. CO.
 Scale 1 in. = 100 Ft.
 Date 1917
 Office of Valuation Engineers, Cincinnati, O.





CROSSING
NO. 14107.1IN

CROSSING
NO. 14244.1IN


Station	A.F.E.	W.P.	Point	Year
11841				
11842				
1951 A.C. Change
1952
1953 1-2-57
1954 5-2-57
1955 4-2-58
1956 18-4-60
1957 18-4-60
1958 No Change
1959 No Change

CONNECTED TO BUCKEYER SHIPS.
CONNECTED TO DECEMBER 31, 1958.
CONNECTED TO DECEMBER 31, 1959.

THE CLEVELAND, CINCINNATI, CHICAGO & ST. LOUIS RY. CO.
RIGHT-OF-WAY AND TRACK MAP
THE CLEVELAND, CINCINNATI, CHICAGO & ST. LOUIS RY. CO.
INDIANAPOLIS DIVISION—MAIN LINE
Scale 1 in. = 200 ft.
June 30th, 1915.
Office of Valuation Engineer, Cincinnati, O.



 


- 1931 No Change
- 1932 " "
- 1933 " "
- 1934 " "
- 1935 " "
- 1936 " "
- 1937 " "
- 1938 " "
- 1939 " "

SHEET NO. 32
 FROM SURVEYING...
 CONNECTED TO DECEMBER 31, 1936
 CONNECTED TO DECEMBER 31, 1937
RIGHT-OF-WAY AND TRACK MAP
 THE CLEVELAND, CINCINNATI, CHICAGO & ST. LOUIS RY.
 OPERATED BY
THE CLEVELAND, CINCINNATI, CHICAGO & ST. LOUIS RY. CO.
 INDIANAPOLIS DIVISION—MAIN LINE
 Scale 1 in. = 200 FT.
 June 30th, 1915.
 Office of Valuation Engineer, Cincinnati, O.

